

MISSISSIPPI DEPARTMENT OF NATURAL RESOURCES

Bureau of Land and Water Resources

Southport Mall

P.O. Box 10631

Jackson, Mississippi 39209

CODED

WATER WELL DRILLERS LOG

TATE
H-94
3-19-81

3-19 1981 Pt. Hicks Well Co. Tate
date well completed firm name county well located

LANDOWNER: Minnie Pearl Mosley
Senator's Lake's Subdivision
Senatobia, Ms.
(mailing address)

description of formations encountered	from	to
Red Clay	0	10
White Clay	10	90
White Sand	90	140

WELL LOCATION:
sec 30 T 5 N R 6 E
3 miles E of Newton
(distance) (direction) (nearest town)


WELL PURPOSE: Home
(home, irrigation, municipal, industrial)

- WELL COMPLETION DATA:
- (1) diameter (inches) 4"
 - (2) total depth (feet) 140
 - (3) static water level (feet) 100 below top of ground.
 - (4) casing PVC 140
(material) (depth)
 - (5) screen 7 133
(length) (depth to top)
4" gravel type
(size) (material)
 - (6) pump 1.2 10
(HP) (yield gpm)
220V
(type power)
 - (7) electric log No
(yes or no)

(organization running log)

(8) how well bottom plugged Cap

DRILLERS REMARKS:

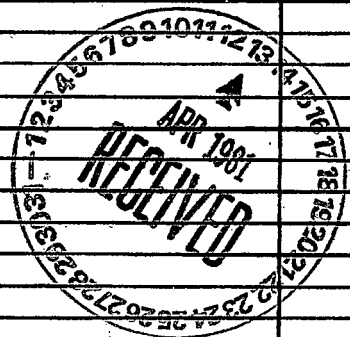


DEPT. OF NATURAL RESOURCES
BUREAU OF LAND & WATER RESOURCES

APR 13 1981

RECEIVED

If well telescopes please sketch and show depths.

GROUND LEVEL

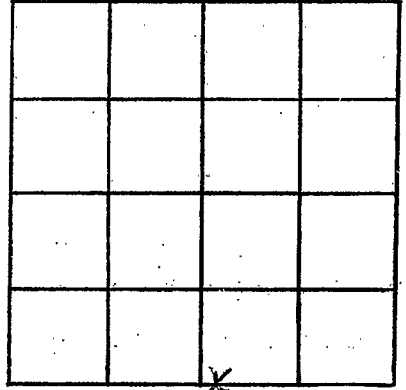

SECTION 30

Please indicate well location X.

ADDITIONAL INFORMATION

If more than one screen,
show locations of each on sketch.