

MISSISSIPPI DEPARTMENT OF ENVIRONMENTAL QUALITY

Office of Land and Water Resources

P. O. Box 10631
Jackson, MS 39299-0631

WATER WELL DRILLERS LOG

COUNTY WELL LOCATED
TATE

WELL NUMBER
491

CODED

H-114

DATE WELL COMPLETED
7-11-03

PERMIT NUMBER

NAME OF DRILLING FIRM
SMITH WELL DRILLING + S&W

NAME & MAILING ADDRESS OF LANDOWNER
GERALD MCABEE
PEYTON RD COLDWATER

Latitude:

Longitude:

WELL LOCATION: SEC D-6 T-5^N R-6^W

DISTANCE 5 Miles DIRECTION E of NEAREST TOWN COLDWATER

OTHER LANDMARK

WELL PURPOSE: Home, Irrigation, Municipal, Industrial, Fish Pond, etc.
HOME

WELL DATA

Well Depth <u>170</u>	Casing Diameter (In.) <u>4"</u>	Casing Length (Ft.) <u>160</u>
Type of Casing <u>PVC</u>	Hole Depth <u>170</u>	Depth to Static Water Level <u>115</u>

TYPE OF COMPLETION: (Circle One or More):
Gravel Packed, Underreamed, Telescoped,
Natural Development, Open Hole, Other
(Describe) WASHED SAND

WELL GROUTED TO A DEPTH OF 10 FEET
Type Grout (circle one): Cement, Bentonite, or Mix

SCREEN DATA

Diameter - Inches <u>4"</u>	Length - Feet <u>10</u>	Slot Size - Inches <u>14/100s</u>
Screen Type <u>PVC</u>	Depth to Bottom - Feet	

PUMP DATA

PUMP TYPE (Circle One):
Submersible Turbine, Jet, Flowing Well,
Other (Describe)

POWER TYPE (Circle One):
Electric Tractor, Diesel, Gasoline, Butane,
Other (Describe) H/P 3/4

DESCRIPTION OF FORMATIONS ENCOUNTERED	FROM	TO
<u>TOP SOIL</u>	<u>0</u>	<u>10</u>
<u>RED + WHITE CLAY</u>	<u>10</u>	<u>40</u>
<u>RED SAND + GRAVEL</u>	<u>40</u>	<u>60</u>
<u>WHITE CLAY</u>	<u>60</u>	<u>110</u>
<u>WHITE SAND CLAY</u>	<u>110</u>	<u>140</u>
<u>WHITE SAND</u>	<u>140</u>	<u>170</u>

RECEIVED

AUG 14 2003

BY: OLWR

Top of Lap Pipe or Reduction in Casing

FEET IF TELESCOPED OR MORE THAN ONE SCREEN: USE BACK PAGE

I certify that the well was drilled, constructed and completed in accordance with all applicable Requirements of the Mississippi Department of Environmental Quality and/or the Mississippi Department of Health regulations and state laws.


[Signature]
Signature of Licensed Driller and License No. 0-645

8-1-03
Date

Additional Information Required On Back

If well telescopes please sketch and show depths.

GROUND LEVEL

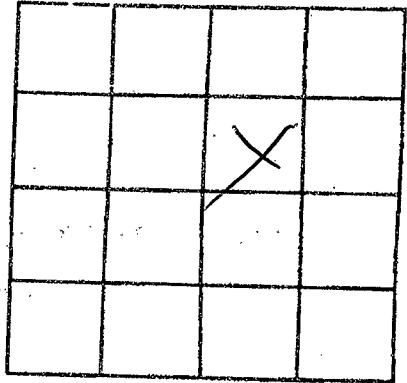

SECTION D-6

Please indicate well location X.

Pump Capacity (GPM)	No. of Stages	Setting Depth
<u>12</u>	<u>11</u>	<u>130</u> FT.

PUMP TEST

Well yielded 15 GPM with
 a drawdown of 3 ft.
 after 1 hours of pumping

LOG DATA

TYPE OF LOG RUN (Circle One): No Log Run, Electric, Gamma Ray, Density, Sonic, Neutron, Other (Describe) _____

Name of Organization Running Log _____

GEOLOGIC DATA (Office Use Only)

Surface Elev.	Geologic Unit	Unit Thickness	Depth to Top
Subs. SWL	Date	Analysis	Aquifer Test

Driller's Remarks

If more than one screen, show location of each on sketch.