

County: ITW  
 Permit #: \_\_\_\_\_  
 Driller: Frank Langford  
 Date drilling completed: 8-28-04

### Well Driller Report and Well Log

Mississippi Department of Environmental Quality  
 Office of Land and Water Resources  
 P.O. Box 10631  
 Jackson, MS 39289-0631  
 (601)961-5210  
 (601)354-6938 (fax)

For Office Use Only:  
 Aquifer: \_\_\_\_\_  
 Well: H 125 137  
 L. S. Elevation: \_\_\_\_\_  
 E-log #: \_\_\_\_\_

State Law requires that this report be prepared by the driller in detail and filed with the Department within 30 days of completion of drilling of the well.

Well Owner Information	Well Location
Owner Name: <u>Al McCormick</u>	Latitude: _____ Longitude: _____
Mailing Address: <u>9352 Peyton Rd</u>	Method of Lat/Long (circle one): <u>Conventional Survey</u> <u>GEN. SURV. MAP</u>
<u>Oldwater MS</u>	USGS quad, Hand-held GPS, Survey-grade GPS
City: _____ State: _____ Zip Code: _____	<u>NW<sup>of</sup> NW 1/4 Sec 4 Twn 5S Rng 6W</u>
Telephone No. (____) <u>NEW MIT-NUMPHY07</u>	Distance: <u>2</u> Miles Direction: <u>E</u> of Nearest Town: <u>Independence</u>

**Well Data**

Purpose of Well (circle one): Home Industrial Public Supply Irrigation Fish Culture Other: **RECEIVED**

Date well drilling started: 8-25-04 Date well drilling completed: 8-25-04 **SEP 10 2004**

If flowing, method of flow regulation: Valve \_\_\_\_\_ Other (describe) \_\_\_\_\_ **BY OLWR**

Static Water Level: 80 feet above or below (circle one) land surface Date measured: 8-28-04

Method of Measurement (circle one): steel tape electric tape air line other: Steel BALL ON STRAP  
MEASURED WITH TAPE

Hole depth: 140 Well depth: 150 Well grouted to a depth of 10 feet

Type of grout (circle one): Cement Bentonite Mix

Casing length: 20 feet Casing diameter: 4 inches Type of casing: PVC

Screen length: 10 feet Screen diameter: 4 inches Type of screen: PVC SLOTTED

Screen slot size: 10/32 inches Setting depth: From 170 feet to 180 feet

Type of completion (circle all applicable): Gravel packed Underreamed Telescoped Open hole Natural Development

Other (describe): \_\_\_\_\_

Top of lap pipe or reduction in casing: None feet. If telescoped or more than one screen, describe on back of page

Logs run (circle all applicable): No log run Electric Gamma Ray Density Sonic Neutron Other: \_\_\_\_\_

Name of organization running log(s): \_\_\_\_\_  
 I certify that the well was drilled, constructed, and completed in accordance with all applicable requirements of the Mississippi Department of Environmental Quality and/or the Mississippi Department of Health regulations and state laws.

Frank Langford C-622  
 Print Name of Water Well Contractor and License No.

Frank Langford  
 Signature of Water Well Contractor

If well construction please sketch below and show depths.

H

Ground Level

Description of Formations Encountered


From To

Description of Formations Encountered	From	To
DIRT	0	5
Red SAND	5	20
Brown SAND	20	60
Mixed w/CLAY SAND	60	90
w/CLAY	90	100
w/SAND	100	150

RECEIVED  
 SEP 10 2004  
 BY: OLWR

If more than one screen, show location of each on sketch

Sketch the property layout and include the following: 1) the well location; 2) any permanent structures on the property that may aid in locating the well; 3) any roads, power lines, or other items that may aid in locating the property and the well; 4) indicate direction.

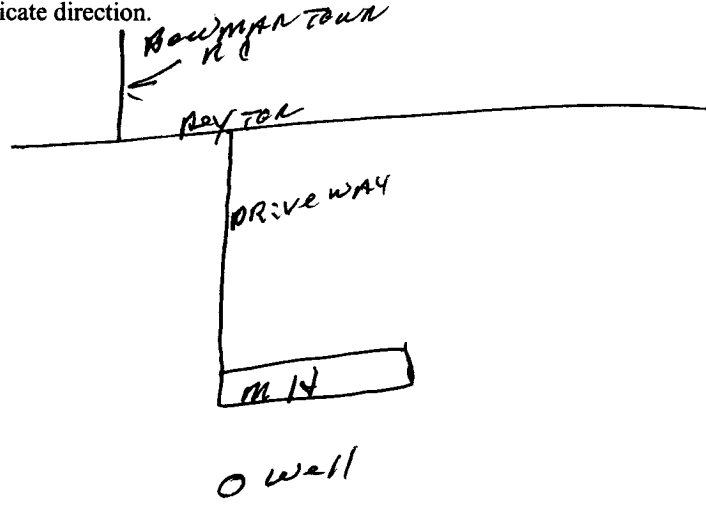

Landowner Name: AL Mc McCormick

Frank Langford  
 Signature of Water Well Contractor

**STATE WELL REPORT**

**Part 2**

**Pump Installer's Completion Report**

Mississippi Department of Environmental Quality  
Office of Land and Water Resources  
P.O. Box 10631  
Jackson, MS 39289-0631  
(601)961-5210  
(601)354-6938 (fax)

For Office Use Only:

Aquifer: \_\_\_\_\_  
Well #: H-125  
Elevation: \_\_\_\_\_

County: TATE  
Permit #: \_\_\_\_\_  
Driller: RANK LANGFORD  
Date completed: 8-28-04

**This report must be prepared by the pump installer in detail and filed with the Department within 30 days of the installation of pump. A copy of Part 1 of this report must be attached to this report.**

Well Owner Information	Well Location
Owner Name: <u>AL Mc CORMICK</u>	Latitude: _____ Longitude: _____
Mailing Address: <u>9302 PEYTON RD</u>	Method of Lat/Long (circle one): <u>Conventional Survey</u> <u>GPS</u>
<u>Caldwateer MS</u>	USGS quad, Hand-held GPS, Survey-grade GPS
City State Zip Code	<u>NW 1/4 NW 1/4 Sec 4 Twn 5 S Rng 6 W</u>
Telephone No. ( ) <u>new address (no rd yet)</u>	Distance Direction Nearest Town
	<u>2</u> Miles <u>E</u> of <u>Independence</u>

**RECEIVED**  
SEP 10 2004  
BY: OLWR

Pump Type Circle one	Power Type Circle one
Air Lift Jet <u>Submersible</u>	Diesel Engine Gasoline Engine Natural Gas
Bucket Piston Turbine	<u>Electric Motor</u> Hand Tractor PTO
Centrifugal Rotary Flowing Well	Windmill Other (specify): _____
Other (specify): _____	Horse Power Rating of Motor: <u>3/4</u>
Date Pump Installed: _____	Setting Depth: <u>120</u> feet
Rated Pump Capacity: <u>12</u> Gallons Per Minute	Number of Stages: <u>12</u>

Pump Test Data	Method of Measuring Water Level Circle one
Date Well Tested: <u>8-28-04</u>	Air Line Electric Measuring Line Steel Tape
Static Water Level (A): <u>80</u> Feet Below Land Surface	Other (specify): <u>STEEL BALL ON STRING</u>
Pumping Water Level (B): <u>90</u> Feet Below Land Surface	<u>MEASURED BY TAP</u>
Drawdown [(B) - (A)]: <u>95</u> Feet Below Land Surface	For flowing well, measured shut in head: _____ feet
Test Pumping Rate: <u>15</u> Gallons Per Minute	Well yielded <u>15</u> GPM with a drawdown of
Duration of Pump Test (minimum 4 hours): <u>5</u> hours	<u>5</u> feet after <u>5</u> hours of pumping

I HEREBY CERTIFY that the above statements are true to the best of my knowledge.

RANK LANGFORD 0-622  
Print Name of Pump Installer and License No. (if applicable)

Frank Langford  
Signature of Pump Installer