r	State Well Report	For Office Use Only:
Tab	Part 1 – Driller's Log	re oline on only.
County: <u>Tote</u>	Mississippi Department of Environmental Quality	Aquifer:
Permit #:	Office of Land and Water Resources	Well #: H-154
5	P.O. Box 10631	
Driller: Jours w.Mc	Jackson, MS 39289-0631	L. S. Elevation:
Date drilling completed: $(0 - 3)$	-07 (601)961-5210	
	(601)354-6938 (fax)	E-log #:

••

...

State Law requires that this report be prepared by the license holder responsible for the work and filed with the Department at the above address within 30 days of completion of drilling of the well or borehole.

Department at the above and ess within 54 ways of comp	Well or Borchole Location	
Information on Well Owner	AA CII OL DOLCHORC I'RCHIME	
(Landowner if borehole is not for a water well)	Latitude: 34 . 40 . 385 Longitude: 89 . 47.583	
Owner Name C-M Builders	3.3 Method of Lat/Long (circle one): Conventional Survey,	
Mailing Address LOT #19	USGS quad, Hand-heid GPS) Survey-grade GPS	
Rowell rd.	Wo 1/2 Sw 1/2 Sec_ Twn_ Ss Rng 6W	
Coldwoter MS 38618- City State Zip Code	$\frac{1}{5W} \frac{1}{1} \frac{1}{5W} \frac{1}{1} \frac{1}$	
City State Zip Code	Distance Direction Nearest Town <u>a</u> Miles <u>SE</u> of <u>Independence</u>	
Telephone No. (101)337-3240		
Weil / Berg	i inde Data	
Date drilling started: $10-3-07$ Date drilling completed: $10-3-07$	0° Hole depth: 151 Hole diameter: $6^{3/4}$	
Location of the source of any surface water used for drilling: NA-		
Method of dosing and volume of Chlorine used in drilling and deve	lopment: M	
Logs run (circle all applicable): No log run Electric Gamma Ray Name of organization running log(s): N-4	Density Sonic Neutron Other:	
Purpose of borehole (check one): Water Well Ceotechnical/Geo	logical Investigation Ground Source Heat Pump	
Scismic Survey Other (describ 	e) m, skip the remainder of this block	
Purpose of Well (check one): Home / Industrial Public Supply Irrigation Fish Culture Other:		
If a flowing well, method of flow regulation: Valve Other (describe)		
Static Water Level: 80 feet above or below (circle one) land surface Date measured: 10-4-07		
Method of Measurement (circle one) steel tape electric tape air line other: String Loveight		
Well depth: 151 Well grouted to a depth of (feet Type of grout (circle one): Neat Cement Bentonite Mix		
Casing length: 141 feet Casing diameter: 4 inches Type of casing:		
Screen length: 10 feet Screen diameter: 4 inches Type of screen:		
Screen slot size: <u>.OlO</u> inches Setting depth: From <u>141</u> feet to <u>151</u> feet		
Type of completion (circle all applicable); Gravel packed Underreamed Telescoped Open hole Natural Development		
Other (describe):		
Top of lap pipe or reduction in casing:feet. If telescoped or more than one screen, describe on next page		
L	Form: OLWR-SWB RECEVE	

NOV 0 5 2037 BY: OLW R


The sketch below only required for water wells

If well telescopes, show depths on sketch. Ground Level_

Description of formations encountered must be provided for all wells and boreholes, unless specifically exempted by regulations

Description of Formations Encountered	From (depth)	To (depth)
clay dirt	Ground Level	30
red soud	30	45
white sond	45	08
white clay	03	100
white sound.	100	151
· · · · · · · · · · · · · · · · · · ·		
		_

If more than one screen, show location of each on sketch

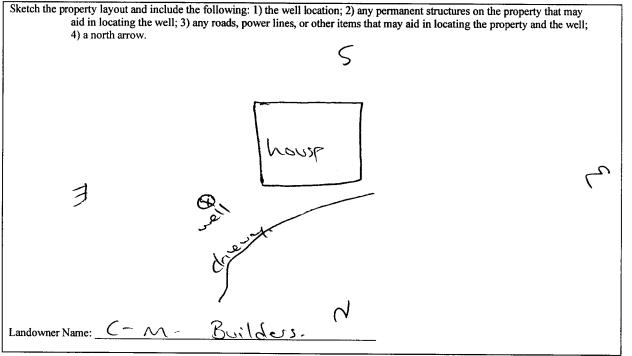

Form: OLWR-SWR-1A

I certify that the well/borehole was drilled, constructed, and completed in accordance with all applicable requirements of the Mississippi Department of Environmental Quality and the Mississippi Department of Health regulations, if applicable, and state laws.

Jones W. Moson 0-620 10-31-07. Print Name of Responsible Licensee and License No.

Janow.N

Signature of Licensee

RECEIVES NOV 0.5 2537

Date

	STATE WELL REPORT	
County: Tote	Part 2 Pump Installer's Completion Report	For Office Use Only:
Permit #:	Mississippi Department of Environmental Quality Office of Land and Water Resources	Aquifer:
Driller: Jours on Mason	P.O. Box 10631	H. 154
Date completed: <u>10-4-07</u>	Jackson, MS 39289-0631 (601)961-5210	Well #:
Copy information from block on Part 1	(601)354-6938 (fax)	Elevation:
This part of the report must be completed by a licensed water well contractor or a licensed pump installer. A copy of Part 1 of the report must be attached and both parts filed with the Department at the above address within 30 days of well completion.		

Well Owner Information	Well Location	
Owner Name: C-M- Builders	Latitude: 34 . 40. 385 Longitude: 87. 47-553	
Mailing Address: LOT # 19	Method of Lat/Long (check one): Conventional Survey,	
Rowell rd	USGS quad, Hand-held GPS, Survey-grade GPS	
City State Zip Code	<u>NW1/2 SW1/4 Sec T 55 R GW</u>	
,,,,,,	Distance Direction Nearest Town	
Telephone No. (901) 337- 3240	<u>A Miles SE of independence</u>	

	Pump Typ Circle on			Power Type Circle one	
Air Lift	Jet	Submersible	Diesel Engine	Gasoline Engine	Natural Gas
Bucket	Piston	Turbine	Electric Motor	Hand	Tractor PTO
Centrifugal	Rotary	Flowing Well	Windmill	Other (specify):	
Other (specify):			Horse Power Rating	g of Motor: 314	
Date Pump Installe	ed: _10 - 4-	07	Setting Depth:	120	feet
Rated Pump Capac	city:(()	Gallons Per Minute	Number of Stages:	1	

Pump Test Data	Method of Measuring Water Level	
Date Well Tested: 10 - 4 - 07	Circle one	
Static Water Level (A): 80 Feet Below Land Surface	Air Line Electric Measuring Line Steel Tape	
	Other (specify): String weight	
Pumping Water Level (B): <u>MA</u> Feet Below Land Surface		
Drawdown [(B) – (A)]:Feet Below Land Surface	For flowing well, measured shut in head:feet	
Test Pumping Rate: (Gallons Per Minute	Well yielded GPM with a drawdown of	
Duration of Pump Test (minimum 4 hours): $\frac{\partial Y}{\partial hours}$	<u></u>	

I HEREBY CERTIFY that the above statements are true to the best of	f my knowledge.
Jones W. Majon 0-620	Gens with an
Print Name of Pump Installer and License No. (if applicable)	Signature of Pump Installer
	RECTER OLVES SWR-1B
	NOV 6 5 20.37
	BY: OLWP