

State Well Report

Part 1

Mississippi Department of Environmental Quality

Office of Land and Water Resources

P.O. Box 2309
Jackson, MS 39225

For Office Use Only

Aquifer: H 167

Well #: _____

L.S. Elevation: _____

E-Long #: _____

County: TAYLOR
Permit #: _____
Driller: BOB SMITH
Date drilling complet: 11-3-09

State Law requires that this report be prepared by the driller in detail and filled will the Department within 30 days of completion of drilling of the well.

Well Owner Information	Well Location
Owner Name: <u>DANIEL LANCE</u>	Latitude: <u>34.37.14</u> "Longitude: <u>89.52.12</u> "
Mailing Address: <u>1509 FOXHOMA</u> <u>CM</u> <u>SEAROCK, MS. 38668</u>	Method of Lat/Long (circle one): Conventional Survey, USGS quad, Hand-held GPS, Survey-grade GPS
City State Zip Code	<u>NW 1/4 SE 1/4 Sect-30 Twn T55 Rng R6W</u>
Telephone No. <u>662 292-2717</u>	Distance Direction Nearest Town <u>1 1/4</u> Miles <u>W</u> of <u>FOXHOMA</u>

Well Data

Purpose of Well (circle one) Home Industrial Public Supply Irrigation Fish Culture Other _____

Date well drilling started: 11-3-09 Date well drilling completed: 11-3-09

If flowing, method of flow regulation: Valve _____ Other (describe) _____

Static Water Level: 80 feet above or below (circle one) land surface Date measured: 11-3-09

Method of Measurement (circle one) steel tape electric tape air line other: LINC & WEIGHT

Hole Depth: 152 Well depth: 152 Well grouted to a depth of 10 feet

Type of grout: (circle one) Cement Bentonite Mix

Casing length: 142 feet Casing diameter: 4 inches Type of casing: PVC

Screen length: 10 feet Screen diameter: 4 inches Type of screen: PVC

Screen slot size: 13 THOUS inches Setting depth: From 142 feet to 152 feet

Type of completion (circle all applicable):
Gravel packed Underreamed Telescoped Open hole Natural Development
Other (describe): _____

Top of lap pipe or reduction incasing: _____ feet. If telescoped or more than one screen, describe on back

Logs run (circle one): No log run Electric Gamma Ray Density Sonic Neutron Other: _____

Name of oorganization running log(s): _____

I certify that the well drilled, constructed, and completed in accordance with all applicable requirements of the Mississippi Department of Environmental Quality and/or the Mississippi Department of Health regulations and state laws.

BOB SMITH 0645
Print name of Water Contractor and License No.

[Signature]
Signature of Water Well Contractor

RECEIVED
NOV 3 2009
BY: OLWR

Ground Level


Description of Formations Encountered

H167
From To

Description of Formations Encountered	From	To
RD SOIL	0	5
BROWN CLAY	5	21
YELLOWISH CLAY	21	39
SAND & GRAVEL	39	65
WHITE CLAY	65	130
WHITE SAND	130	152

If more than one screen, show location of each on sketch

Sketch the property layout and include the following: 1) the well location; 2) any permanent structures on the property that may aid in locating the well; 3) any roads, power lines, or other items that may aid in locating the property and the well; 4) indicate direction.

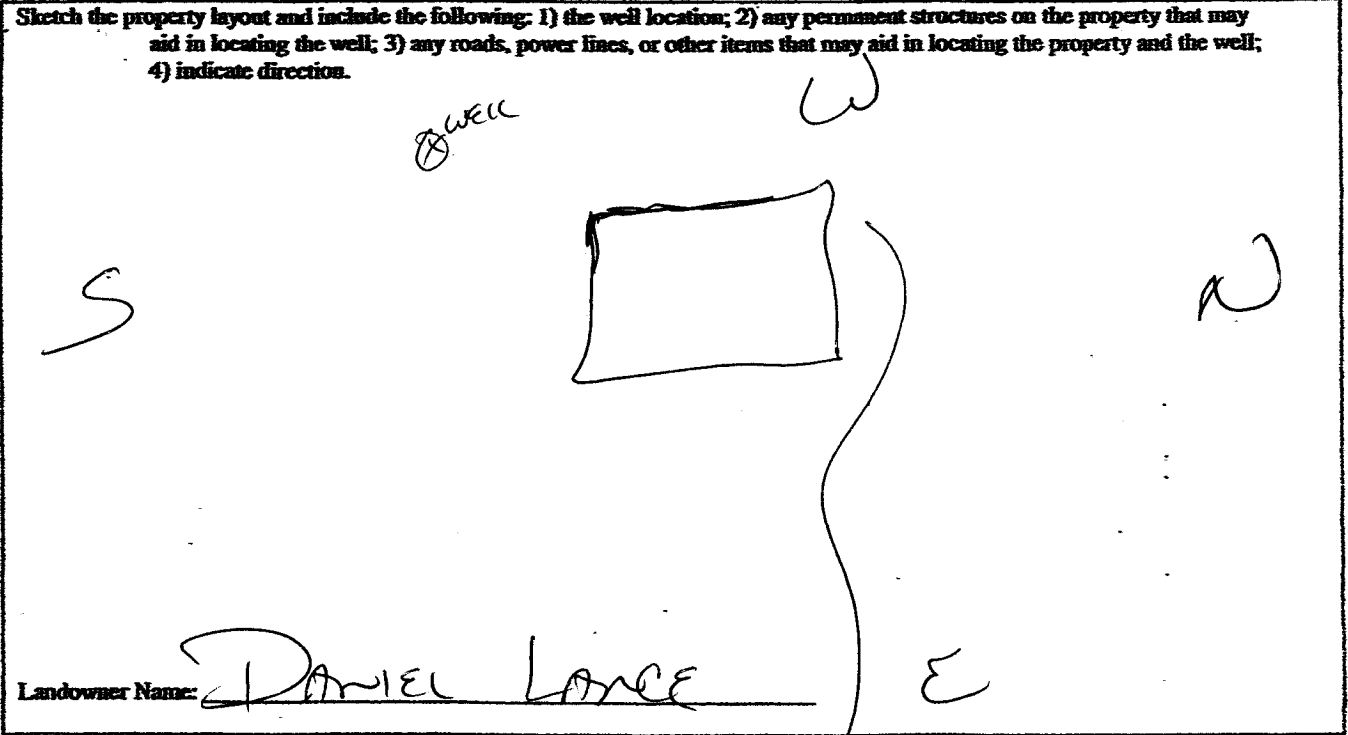

Landowner Name:

DANIEL LANCE

Signature of Water Well Contractor

RECEIVED

NOV 30 2009

BY: OLWR

State Well Report

Part 2

Pump Installer's Completion Report
Mississippi Department of Environmental Quality
Office of Land and Water Resources
P.O. Box 2309
Jackson, MS 39225

For Office Use Only	
Aquifer:	<u>H167</u>
Well #:	_____
Elevation:	_____

County:	<u>LAFAYETTE</u>
Permit #:	_____
Driller:	<u>BOB SMITH</u>
Date completed:	<u>11-3-09</u>

This report be prepared by the pump installer in detail and filled will the Department within 30 days of completion of drilling of the well.

Well Owner Information	Well Location
Owner Name: <u>DANIEL LARCE</u>	Latitude: _____ Longitude: _____
Mailing Address: <u>1509 BOX 14217</u> <u>CAIN</u> <u>SEABOARD, MS. 38668</u>	Method of Lat/Long (circle one): Conventional Survey USGS quad, Hand-held GPS, survey grade GPS
City State Zip Code	<u>1/4</u> <u>1/4</u> Sec <u>E-30</u> Twn <u>T55</u> Rng <u>R6W</u>
Telephone No. <u>662 292-2717</u>	Distance <u>1 1/4</u> miles Direction <u>W</u> Nearest Town of <u>BOX 14217</u>

Pump Type	Power Type
Circle one	Circle one
Air lift Jet <u>Submersible</u>	Diesel Engine Gasoline Engine Natural Gas
Bucket Piston Turbine	<u>Electric Motor</u> Hand Tractor PTO
Centrifugal Rotary Flowing Well	Windmill Other(specify): _____
Other (specify): _____	Horse Power Rating of Motor: <u>3/4</u>
Date Pump Installed: <u>11-3-09</u>	Setting Depth: <u>100</u> feet
Rated Pump Capacity: <u>12</u> gallons per min	Number of Stages: <u>11</u>

Pump Test Data	Method of Measuring Water Level
Date Well Tested: <u>11-3-09</u>	circle one Air Line Electric Measuring Line Steel Tape
Static Water Level(A): <u>80</u> feet below Land Surface	Other(specify): <u>LINE + WEIGHT</u>
Pumping Water Level(B): _____ feet below Land Surface	For flowing well, measured shut in head: _____ feet
Drawdown((B)-(A)): _____ feet below Land Surface	Well yielded <u>17</u> GPM with a drawdown of _____ feet after _____ hours of pumping
Test Pumping Rate: <u>12</u> gallons per Minute	
Duration of Pump Test(minimum 4 hours): _____ hrs	

I HEREBY CERTIFY that the above statements are true to the best of my knowledge.

BOB SMITH 0645 _____
Print Name of Pump Installer and License No. Signature of Pump Installer

RECEIVED

NOV 5 2009

BY: OIWE