	State W	ell Report	
County: Tate		Priller's Log	For Office Use Only:
Permit #:	Mississippi Department of Environmental Quality Office of Land and Water Resources		Aquifer:
Driller: Jones w. Mason		Box 2309 , MS 39225	Well #:
Date drilling completed: 8-14-11	(601)9	961- 5210	L. S. Elevation:
Date draining completed.	(601)961	I- 5228 (fax)	E-log #:
State Law requires that this repor Department at the above address			he work and filed with the
Information on Well O	wner		rehole Location
(Landowner if borehole is not fo	· ·	Latitude: 34 o 41 ,025	" Langituda: 89 ° 50 , 118"
Owner Name Dovid Mcdox	vold.		" Longitude: 89 • 50 , 118"
Mailing Address: 9450 Perto		Method of Lat/Long (circle on	_
		USGS quad, Hand-held	GPS Survey-grade GPS
- 11 - 1	28618	NE 14 NW 14 Sec 4	Twn 55 Rng 6W
City State	e Zip Code	NW NE Distance Direction	Nearest Town
Telephone No. (62) 292-379	•	1'18 Miles 5 = 0	Nearest Town of <u>Boumon</u>
Telephone No. (88)			
	Well / Borel	nole Data	
Date drilling started: 8-14-11 Date dril	lling completed: 8-14-1	1 Hole depth: 170'	Hole diameter: 63/4
Location of the source of any surface water Method of dosing and volume of Chlorine	used in drilling and develo	opment:	
Logs run (circle all applicable): No log run Name of organization running log(s):	Electric Gamma Ray	Density Sonic Neutron C	Other:
Purpose of borehole (check one): Water We	ellGeotechnical/Geolo	gical Investigation Ground	Source Heat Pump
	urvey Other (describe)		
If drilling is not related	to water well construction	, skip the remainder of this blo	ck
Purpose of Well (check one): Home In	dustrial Public Supply_	Irrigation Fish Culture _	Other:
If a flowing well, method of flow regulation	: Valve Of	her (describe)	
Static Water Level: 65 feet abo			•
Method of Measurement (circle one) steel tape electric tape air line other: String weight			
Well depth: 170 Well grouted to a depth of 10 feet Type of grout (circle one): Neat Cemen Bentonite Mix			
Casing length: 160 feet Casing	g diameter: 4	_inches Type of casing:	psc
Screen length: 10 feet Screen	n diameter:	_inches Type of screen:	ρυς
Screen slot size:, Oloinches Setting depth: From / 60feet to / 70feet			
Type of completion (circle all applicable): Gravel packet Underreamed Telescoped Open hole Natural Development			
	Other (describe):	M	
Top of lap pipe or reduction in casing:	feet. If tele	scoped or more than one screer	ı, describe on next page

Form: OLWR-SEADORED


The sketch	below	only	reauired	for	water wells

Description of formations encountered must be provided for all wells and boreholes, unless specifically exempted by regulations

If well telescopes, show depths on sketch. Ground Level————			
Ground Level			
X	Τ		
	Ì		
	1		
	ľ		
	l	\$	

Description of Formations Encountered	From (depth)	To (depth)
clay dirt red sand while sand	Ground Level	15
IEd soud	15	20
unite soud	20	120
· · · · · · · · · · · · · · · · · · ·		

If more than one screen, show location of each on sketch

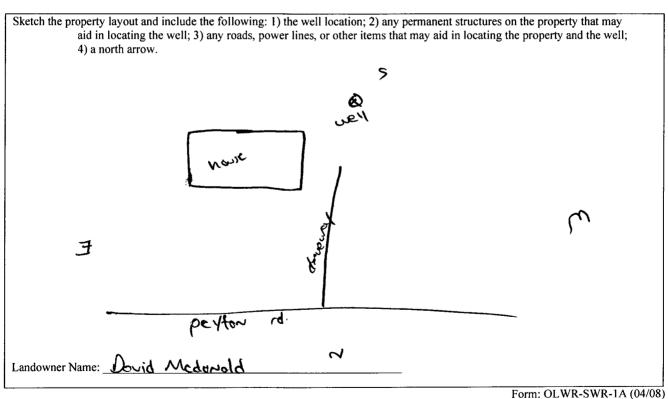

I certify that the well/borehole was drilled, constructed, and completed in accordance with all applicable requirements of the Mississippi Department of Environmental Quality and the Mississippi Department of Health regulations, if applicable, an laws.

Print Name of Responsible Licensee and License No.

Date

Signature of Licensee

BY: DIMA

STATE WELL REPORT

County: Tate Permit #: Driller: James

Part 2

Pump Installer's Completion Report
Mississippi Department of Environmental Quality
Office of Land and Water Resources
P.O. Box 2309

For Office Use Only:			
Aquifer:			
Well #:	H169		
Elevation:			

Date completed: 8-14-11		, MS 39225 961-5210		11101
Copy information from block on Part 1	,	1-5228 (fax)	Elevation:	
This part of the report must be completed by a licensed water well contractor or a licensed pump installer. A copy of Part 1 of the report must be attached and both parts filed with the Department at the above address within 30 days of well completion.				y of Part 1 of the upletion.
Well Owner Informat			Well Location	
Owner Name: Dovid Mcdu	blov	Latitude: 34. 41.	Longitude: 8	19.50. U8
Mailing Address: 9450 PC4	ton 1d	Method of Lat/Long (check one): Conventional Survey,		
		USGS quad, Hand-held GPS, Survey-grade GPS		
Coldwater M. 38618 City State Zip Code		NN NE Distance Direction Nearest Town		
Telephone No. (42) 292 - 3	794	i'l8 Miles 3	SE of Bow	mor
Pump Type			Power Type	
Circle one			Circle one	
Air Lift Jet (Submersible	Diesel Engine	Gasoline Engine	Natural Gas
Bucket Piston	Turbine	Electric Motor	Hand	Tractor PTO
Centrifugal Rotary	Flowing Well	Windmill	Other (specify):	İ
Other (specify):		Horse Power Rating	of Motor: 3/	<u> </u>
Date Pump Installed: 8-14-11		Setting Depth:	80	feet
Rated Pump Capacity: 10	_Gallons Per Minute	Number of Stages:	()	
Pump Test Data		Meth	nod of Measuring Wate	r Level
		Wich	Circle one	
Date Well Tested: 8-14-11		Air Line Ele	ectric Measuring Line	Steel Tape
Static Water Level (A): 65 Feet Below Land Surface		Other (specify):	string/weig	\
Pumping Water Level (B):Feet Below Land Surface		Cules (opens).		
Drawdown [(B) – (A)]:Feet Below Land Surface		For flowing well, measured shut in head:		
Test Pumping Rate: (Well yieldedGPM with a drawdown of		
Duration of Pump Test (minimum 4 hours)	hours	f	eet after 2 4	hours of pumping

I HEREBY CERTIFY that the above statements are true to the best of	my knowledge.	
Jones W. Mason 0-620	Signature of Pump Installer	
Print Name of Pump Installer and License No. (if applicable)	Signature of Pump Installer Form: OLWF	R-SWR-1B (04/08)