

STATE WELL REPORT

Part 1

Driller's Log

Mississippi Department of Environmental Quality
Office of Land and Water Resources
P.O. Box 2309
Jackson, MS 39225-2309
(601)961-5210
(601)360-0535 (fax)

For Office Use Only:

Well #: H182
Aquifer: _____
E-Log #: _____

County: Tate
Permit #: _____
Driller: James W. Mason
Date drilling completed: 5-15-14

State Law requires that this report be prepared by the license holder responsible for the work and filed with the Department at the above address within 30 days of completion of drilling of the well or borehole.

Well Owner Information (Landowner if borehole is not for a water well)	Well or Borehole Location
Owner Name: <u>Trent Ross</u>	Latitude: <u>34°41'00.51" N</u> Longitude: <u>89°50'20.97" W</u>
Mailing Address: <u>9264 Peyton rd.</u>	Method of Lat/Long (check one): Conventional Survey _____, USGS quad _____, Hand-held GPS <input checked="" type="checkbox"/> , Survey-grade GPS _____
<u>Coldwater</u> City <u>MS</u> State <u>38618</u> Zip Code	<u>NE</u> 1/4 <u>NW</u> 1/4, Sec <u>4</u> T <u>5S</u> R <u>6W</u>
Telephone No. <u>(901) 508-6207</u>	<u>1 1/2</u> Miles <u>E</u> of <u>Poagville</u> (Distance) (Direction) (Nearest Town)

Well / Borehole Data

Date drilling started: 5-15-14 Date drilling completed: 5-15-14 Hole depth: 140 Hole diameter: 63/4
Location of the source of any surface water used for drilling: N/A
Method of dosing and volume of Chlorine used in drilling and development: 5 ppm and greater
Logs run (circle all applicable): No log run Electric Gamma Ray Density Sonic Neutron Other: _____
Name of organization running log(s): N/A
Purpose of borehole (circle one): Water Well Geotechnical/Geological Investigation Ground Source Heat Pump
Seismic Survey Other (describe) N/A

If drilling is not related to water well construction, skip the remainder of this block

Purpose of Well (circle all applicable): Home Industrial Public Supply Irrigation Fish Culture
Other (describe): N/A
If a flowing well, method of flow regulation: Valve N/A Other (describe) _____
Static Water Level: 90 feet [above or below land surface (circle one) Date measured: 5-15-14
Method of measurement (circle one): Steel tape Electric tape Air line Other (describe): String weight
Well depth: 140 Well grouted to a depth of: 10 feet Type of grout (circle one): Neat Cement Bentonite Mix
Casing length: 130 feet Casing diameter: 4 inches Type of casing: pvc
Screen length: 10 feet Screen diameter: 4 inches Type of screen: pvc
Screen slot size: .010 inches Setting depth: From 130 feet to 140 feet
Type of completion (circle all applicable): Gravel packed Underreamed Open hole Natural Development
Other (describe): N/A
Top of lap pipe or reduction in casing: N/A feet

If telescoped or more than one screen, describe on next page

RECEIVED

JUN 18 2014

BY: OLWR


Form: OLWR-SWR-1A (4/13)

County: _____
 Permit #: _____

For Office Use Only:
 Well #: H182

The sketch below only required for water wells

If well telescopes, show depths on sketch.

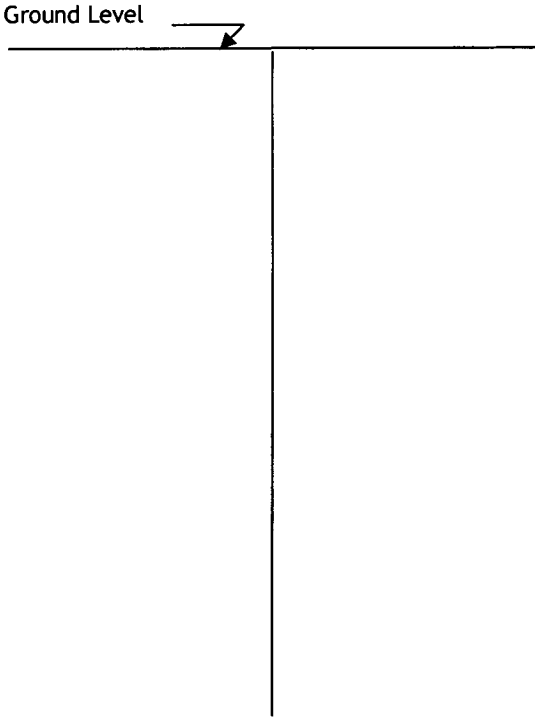


Description of formations encountered must be provided for all wells and boreholes, unless specifically exempted by regulations

Description of Formations Encountered	From (depth)	To (depth)
clay dirt.	Ground level	10
red sand	10	35
white sand	35	70
white clay	70	90
white sand	90	100
white clay	100	105
white sand	105	140

If more than one screen, show location of each on sketch

- Sketch the property layout and include the following:
- 1) the well location
 - 2) any permanent structures on the property that may aid in locating the well
 - 3) any roads, power lines, or other items that may aid in locating the property and the well
 - 4) north arrow

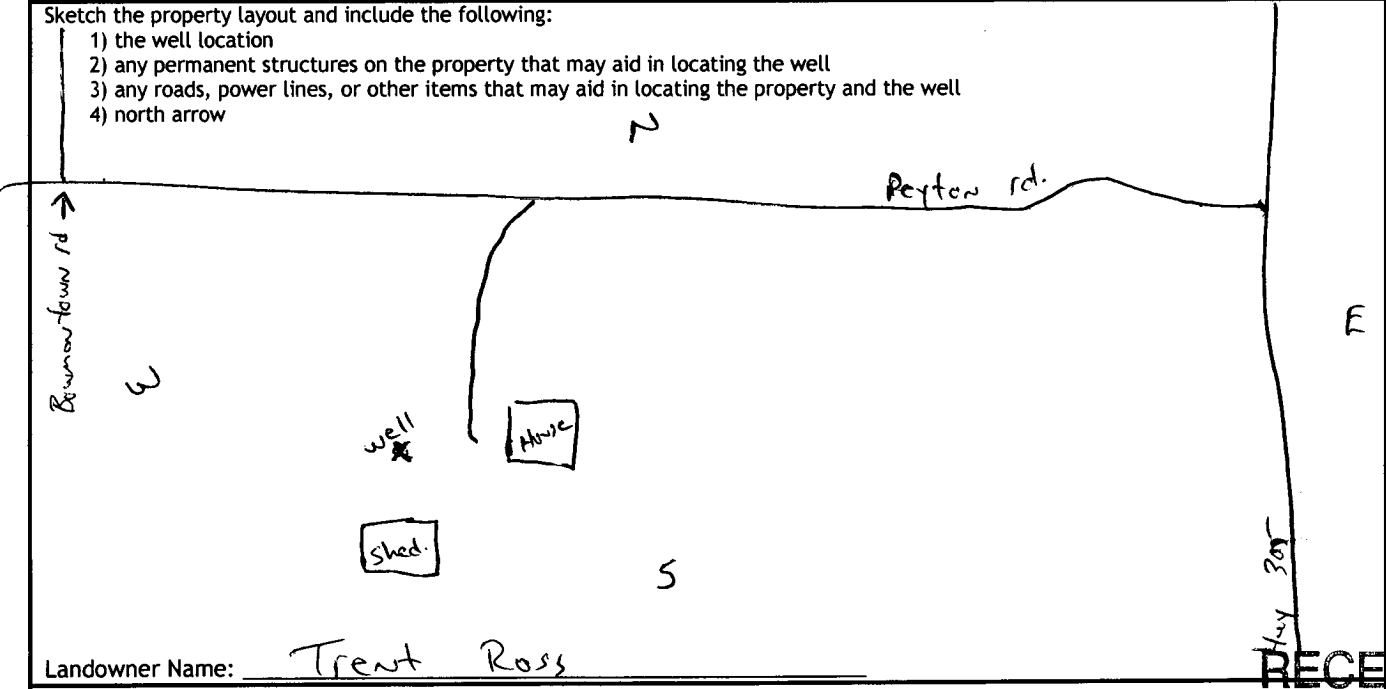

Landowner Name: Trent Ross

RECEIVED

I HEREBY CERTIFY that the well/borehole was drilled, constructed, and completed in accordance with all applicable requirements of the Mississippi Department of Environmental Quality and the Mississippi Department of Health regulations, if applicable, and state laws. JUN 18 2014

Jones W. Mason 0-620
 Print Name of Responsible Licensee and License No.

6-13-14
 Date

Jones W. Mason
 Signature of Licensee

BY: OLWR

STATE WELL REPORT

Part 2

Pump Installer's Completion Report
 Mississippi Department of Environmental Quality
 Office of Land and Water Resources
 P.O. Box 2309
 Jackson, MS 39225-2309
 (601)961-5210
 (601) 360-0535 (fax)

For Office Use Only:

Well #: H182
 Aquifer: _____

County: Tate
 Permit #: _____
 Driller: Jones w. Mason
 Date completed: 5-15-14
Copy information from block on Part 1

This part of the report must be completed by a licensed water well contractor or a licensed pump installer. A copy of Part 1 of the report must be attached and both parts filed with the Department at the above address within 30 days of well completion.

Well Owner Information	Well Location
Owner Name: <u>Trent Ross</u>	Latitude: <u>34°41'00.51N</u> Longitude: <u>89°50'20.97W</u>
Mailing Address: <u>9264 peyton rd</u>	Method of Lat/Long (check one): Conventional Survey _____, USGS quad _____, Hand-held GPS <input checked="" type="checkbox"/> , Survey-grade GPS _____
<u>coldwater</u> <u>MS</u> <u>38618</u>	<u>NW 1/4</u> <u>NE 1/4</u> , Sec <u>4</u> T <u>5S</u> R <u>6W</u>
City State Zip Code	<u>1 1/2</u> Miles <u>E</u> of <u>Poagville</u>
Telephone No. <u>(901) 508-6207</u>	(Distance) (Direction) (Nearest Town)

Pump Type (circle one)

Submersible Turbine Air Lift Centrifugal Flowing Well Jet Piston Rotary Other (describe): _____

Date Pump Installed: 5-15-14 Rated Pump Capacity: 10 Gallons Per Minute

Is This Pump (circle one): New Repaired Replacement

Power Type (circle one)

Electric Diesel Gasoline Natural Gas Tractor PTO Windmill Other (describe): _____

Horse Power Rating of Motor: 3/4 Setting Depth: 120 feet Number of Stages: 8

Pump Test Data for Non Flowing Well

Date Well Tested: 5-15-14 Duration of Pump Test (minimum 4 hours): 24 hours

Static Water Level (A): 90 Feet Below Land Surface Pumping Water Level (B): N/A Feet Below Land Surface

Drawdown [(B) - (A)]: N/A Feet Below Land Surface Test Pumping Rate: 10 Gallons Per Minute

Method of measurement (circle one): Steel tape Electric tape Air line Other (describe): string weight

Pump Test Data for Flowing Well

Measured shut in head: N/A feet.

Well yielded 10 GPM with a drawdown of N/A feet after 24 hours of pumping

Meter Installation

Meter Manufacturer: N/A Meter Serial Number: N/A

Meter Model Number/Name: N/A Type of Meter: N/A

Totalizer Register Unit and Multiplier Factor (AF x .001, gal x 1000, etc): N/A

Installation Date: N/A Meter installed by: N/A

Is This Meter (circle one): New Repaired Replacement

RECEIVED
JUN 18 2014
BY: OLWR

Important: By submitting the above information you are certifying that this meter was installed to manufacturer standards. For agricultural wells, a list of approved meters is on the MDEQ website.

I HEREBY CERTIFY that the above statements are true to the best of my knowledge.

Jones w. Mason 0-620 6-13-14 Jones w. Mason
 Print Name of Pump Installer and License No. (if applicable) Date Signature of Pump Installer