

TATE

H 300
11-60

WATER WELL DRILLERS LOG

H 30 R

Date: Nov, 1960, Driller: Lamar Probert County: Ita-
(Name)

(1) Owner of Land: Malcolm Dickerson
(Name)
Rt 1 Senatobia
(Address)

(2) Location: SW 1/4, 1/4, Sec. 28 T5 R4
1/4 miles west of Senatobia
(distance) (direction) (Nearest Town)

(3) Topography: X
(Hilly) (Flat) (Level)

(4) Purpose of Well: Home
(Domestic Irrigation
Municipal, Industrial, Other)

Description & Color of Materials Sand, Clay, Red Clay, Shell, etc.	Thick- ness Feet	Depth Feet
<u>Clay & sand</u>	<u>20</u>	
<u>Gravel</u>	<u>30</u>	
<u>Gravel</u>	<u>40</u>	

Information upon completion of well:

(1) Diameter 2 1/2 inches.

(2) Total Depth 90 feet.

(3) Water Level 70 feet below top of ground.


(4) Cased to _____, Size _____

(5) Screen: Size 90, Length 6 ft.

(6) Were any formations sealed against pollution?
_____ yes, X no.

If YES depth of formation _____
Why _____

Drillers Remarks: _____

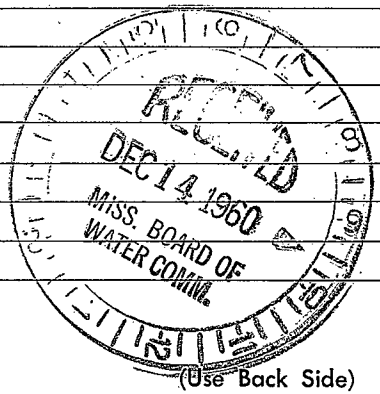

Well No.

