

H 2005  
12-61

WATER WELL DRILLERS LOG


Date: Dec, 1961, Driller: James W. ... County J.T.  
(Name)

(1) Owner of Land: Jessie Davis  
(Name)  
Caldwells Pt. 1  
(Address)  
(2) Location: S 1/4, SE 1/4, Sec. 1 T. 56 N. R. 6 E.  
2 miles S. E. of ... ..  
(distance) (direction) (Nearest Town)  
(3) Topography: X  
(Hilly) (Flat) (Level)  
(4) Purpose of Well: Domestic  
(Domestic Irrigation, Municipal, Industrial, Other)

Description & Color of Materials Sand, Clay, Red Clay, Shell, etc.	Thick- ness Feet	Depth Feet
<u>Red Clay - 3 in</u>	<u>20</u>	
<u>then Red sand</u>	<u>15</u>	
<u>then pipe core</u>	<u>10</u>	
<u>then white sand</u>	<u>24</u>	

Information upon completion of well:

(1) Diameter 2 1/2 inches.  
(2) Total Depth 69 feet.  
(3) Water Level 40 feet below top of ground.  
(4) Cased to \_\_\_\_\_, Size \_\_\_\_\_  
(5) Screen: Size 6, Length 4  
(6) Were any formations sealed against pollution?  
\_\_\_\_\_ yes, 1 no.  
If YES depth of formation \_\_\_\_\_  
Why \_\_\_\_\_  
Drillers Remarks: \_\_\_\_\_

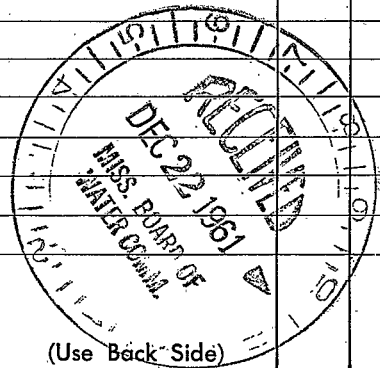

Well No. \_\_\_\_\_

(Use Back Side)

