

MISSISSIPPI
 BOARD OF WATER COMMISSIONERS
 416 North State Street
 Jackson, Mississippi 39201

WATER WELL DRILLERS LOG

Zate
H 2008
11-66

11 date well completed 19 66 Harris Bros. Zate firm name county well located


LANDOWNER: J. B. House
Rte. 2
Coldwater
 (mailing address)

description of formations encountered	from	to
<u>top soil</u>	<u>0</u>	<u>15</u>
<u>red clay sand</u>	<u>15</u>	<u>50</u>
<u>white clay sand</u>	<u>50</u>	<u>90</u>
<u>Coarse white sand</u>	<u>90</u>	<u>100</u>

WELL LOCATION:
 sec. 14 T. 5 N. R. 6 E.
3 miles S. of Indep.
 (distance) (direction) (nearest town)

WELL PURPOSE: home
 (home, irrigation, municipal, industrial)


WELL COMPLETION DATA:
 (1) diameter (inches) 4
 (2) total depth (feet) 100
 (3) static water level (feet) 40 below above top of ground.
 (4) casing Plastic 92' (material) (depth)
4" (size) if telescope see back.
 (5) screen 7' 93' (length) (depth to top)
.008 Plastic (size) (material)
 (6) pump 3/4 7 (HP) (yld gpm)
elec. (type power)
 (7) electric log no (yes or no)
 (organization running log)
 (8) how well bottom plugged back shot

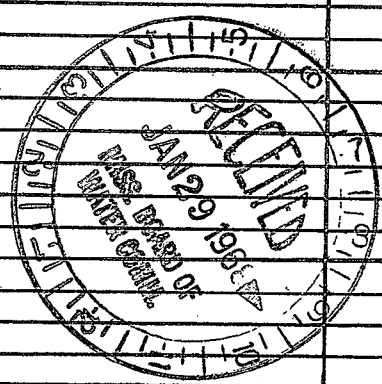

DRILLERS REMARKS:

If well telescopes please sketch and show depths.

GROUND LEVEL

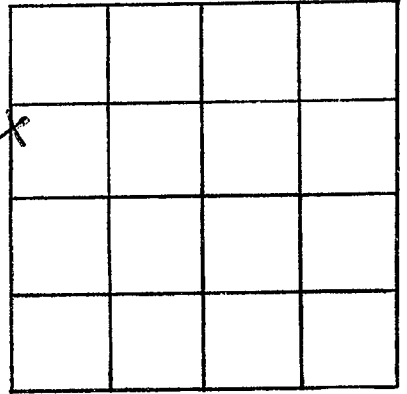

SECTION 14

Please indicate well location X.

ADDITIONAL INFORMATION

If more than one screen, show locations of each on sketch.