

Late
H 2008
8-67

MISSISSIPPI
 BOARD OF WATER COMMISSIONERS
 416 North State Street
 Jackson, Mississippi 39201

WATER WELL DRILLERS LOG

8-5 date well completed 1967 Harris Bros. firm name Late county well located


LANDOWNER: Preston Pope
Rte. 2
Caldwater, Miss.
 (mailing address)

description of formations encountered	from	to
<u>top soil</u>	<u>0</u>	<u>25</u>
<u>red sand + clay</u>	<u>25</u>	<u>50</u>
<u>W. sand + clay</u>	<u>50</u>	<u>90</u>
<u>W. sand</u>	<u>90</u>	<u>100</u>

WELL LOCATION:
 sec 3 T 5 N R 6 E
1 3/4 miles South of Independence
 (distance) (direction) (nearest town)

WELL PURPOSE: none
 (home, irrigation, municipal, industrial)


- WELL COMPLETION DATA:
- (1) diameter (inches) 4"
 - (2) total depth (feet) 100'
 - (3) static water level (feet) 60 below above top of ground.
 - (4) casing Plastic 93'
 (material) (depth)
4 if telescope see back.
 (size)
 - (5) screen 7' 93'
 (length) (depth to top)
008 Plastic
 (size) (material)
 - (6) pump 3/4 7
 (HP) (yield gpm)
elec.
 (type power)
 - (7) electric log no
 (yes or no)
 (organization running log)
 - (8) how well bottom plugged Back
shot

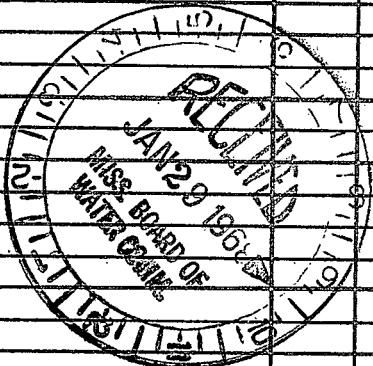

DRILLERS REMARKS:

If well telescopes please sketch and show depths.

GROUND LEVEL

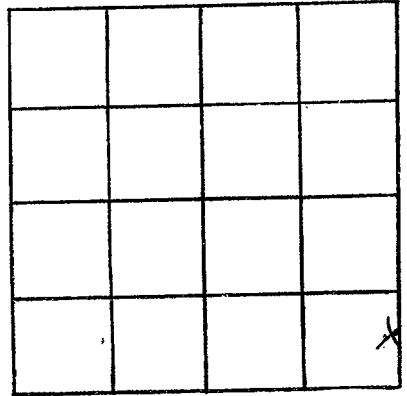

SECTION 3

Please indicate well location X.

ADDITIONAL INFORMATION

If more than one screen, show locations of each on sketch.