

TATE
H 2010
12-67

MISSISSIPPI
BOARD OF WATER COMMISSIONERS
416 North State Street
Jackson, Mississippi 39201

WATER WELL DRILLERS LOG

12-15 19 ~~1967~~ 1967 Harris Bros. Tate
date well completed firm name county well located

LANDOWNER: James Clinton

Rt. 2

Coldwater
(mailing address)

description of formations encountered	from	to
top soil	0	20
red sand	20	45
clay + sand	45	80
coarse white sand	80	100

WELL LOCATION:


sec. 2 T 5 N R 6 E
1 miles S 2.1 E of Independence
(distance) (direction) (nearest town)

WELL PURPOSE: home
(home, irrigation, municipal, industrial)

WELL COMPLETION DATA:

- (1) diameter (inches) 4"
- (2) total depth (feet) 100
- (3) static water level (feet) 60 ^{below} top of ground.
- (4) casing Plastic, 93' (material) (depth)
4" if telescope see back. (size)
- (5) screen 7' 93' (length) (depth to top)
.008 Plastic (size) (material)
- (6) pump 3/4 7 (HP) (yield gpm)
elec (type power)
- (7) electric log no (yes or no)
(organization running log)
- (8) how well bottom plugged back shot

DRILLERS REMARKS:

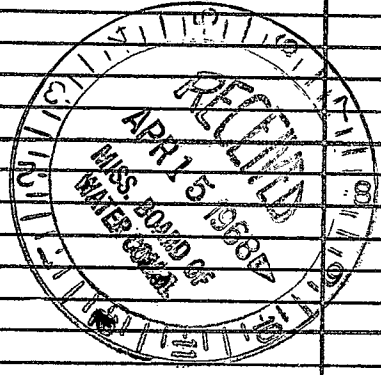

If well telescopes please sketch and show depths.

GROUND LEVEL

			X

SECTION 2

Please indicate well location X.

ADDITIONAL INFORMATION

If more than one screen,
show locations of each on sketch.