

**MISSISSIPPI
BOARD OF WATER COMMISSIONERS**
416 North State Street
Jackson, Mississippi 39201

WATER WELL DRILLERS LOG

TATE
H 2011
4-68

4-16 1968 Robert Wilson Tate
date well completed firm name county well located

LANDOWNER: W.E. Smith
Senitobia
Miss.
(mailing address)

description of formations encountered	from	to
<u>Red Clay</u>	<u>0</u>	<u>20</u>
<u>Blue Clay</u>	<u>20</u>	<u>80</u>
<u>White Sand</u>	<u>80</u>	<u>130</u>

WELL LOCATION:
sec. 35 T 5 N R 6 E
1/2 miles W of LOOXAHOMA
(distance) (direction) (nearest town)

WELL PURPOSE:
(home, irrigation, municipal, industrial)

- WELL COMPLETION DATA:
- (1) diameter (inches) 4
 - (2) total depth (feet) _____
 - (3) static water level (feet) 80 below top of ground.
 - (4) casing plastic 129 (material) (depth)
 - _____ (size) If telescope see back.
 - (5) screen 4' (length) 120 (depth to top)
 - 4 (size) Cannel Pack (material)
 - (6) pump _____ (HP) _____ (yield gpm)
 - Elect. (type power)
 - (7) electric log _____ (yes or no)

_____ (organization running log)


(8) how well bottom plugged plastic cap

DRILLERS REMARKS: _____

MAY 2 1968
MISS. BOARD OF
WATER COMMISSIONERS

If well telescopes please sketch and show depths.

GROUND LEVEL

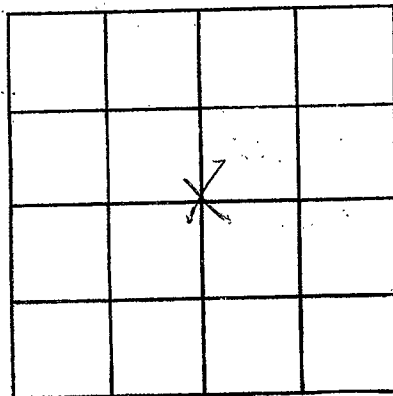

SECTION 25

Please indicate well location X.

ADDITIONAL INFORMATION

If more than one screen, show locations of each on sketch.