

TATE  
H 20W  
4-68

MISSISSIPPI  
BOARD OF WATER COMMISSIONERS  
416 North State Street  
Jackson, Mississippi 39201

WATER WELL DRILLERS LOG

4-17 1968 Robert Wilson Tate  
date well completed firm name county well located

LANDOWNER: Charles McDonald  
Coldwater  
Miss.  
(mailing address)

description of formations encountered	from	to
Red clay + Red Sand	0	20
Gravelly white clay	20	40
white clay	40	70
white clay + white sand	70	100
white sand	100	120

WELL LOCATION:  
sec. 9 T. 5 N. R. 6 E.  
2 1/2 miles (direction) SE of (nearest town) Pearl

WELL PURPOSE:  
(home, irrigation, municipal, industrial)

WELL COMPLETION DATA:  
(1) diameter (inches) 4  
(2) total depth (feet) 120  
(3) static water level (feet) 70 below top of ground.  
(4) casing plastic, 1 1/2" (material) (depth)  
if telescope see back.  
(5) screen 4' (length), 1 1/2" (depth to top)  
4" gravel pack (size) (material)  
(6) pump (HP) (yield gpm)  
Elect. (type power)  
(7) electric log (yes or no)


(organization running log)  
(8) how well bottom plugged plastic cap 4"

DRILLERS REMARKS:

MAY 27 1968  
MISS. BOARD OF  
WATER COMMISSIONERS

If well telescopes please sketch and show depths.

GROUND LEVEL

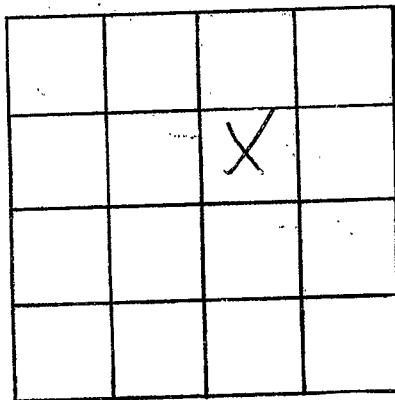

SECTION 9

Please indicate well location X.

ADDITIONAL INFORMATION

If more than one screen, show locations of each on sketch.