

**MISSISSIPPI
BOARD OF WATER COMMISSIONERS**
416 North State Street
Jackson, Mississippi 39201

WATER WELL DRILLERS LOG

TATE
H. J. JAY
12-9-75

12-9-1975 ^{15E} *W.A. Mason* *Water Well Contractor* *Tate*
date well completed firm name county well located

LANDOWNER:
Thomas White/aw
Rt. 2 - Senatobia Miss
(mailing address)

description of formations encountered	from	to
<i>Clay Dirt</i>	<i>to</i>	<i>10</i>
<i>Red sand</i>	<i>10</i>	<i>30</i>
<i>white sand</i>	<i>30</i>	<i>135</i>

WELL LOCATION:
16 sec. *10* T. *10* N. *5* R. *15* E. *5* W.
5 miles *South* of *Senatobia*
(distance) (direction) (nearest town)

WELL PURPOSE: *Home*
(home, irrigation, municipal, industrial)


- WELL COMPLETION DATA:**
- (1) diameter (inches) *4"*
 - (2) total depth (feet) *135'*
 - (3) static water level (feet) *65'* below top of ground.
 - (4) casing *Plastic* *125'*
(material) (depth)
4"
(size) if telescope see back.
 - (5) screen *10'* *125'*
(length) (depth to top)
4" *Plastic*
(size) (material)
 - (6) pump *1/3* *5*
(HP) (yield gpm)
electric
(type power)
 - (7) electric log *NO*
(yes or no)
- (organization running log)

DRILLERS REMARKS:
Cap on screen

RECEIVED
FEB 17 1976

If well telescopes please sketch and show depths.

GROUND LEVEL

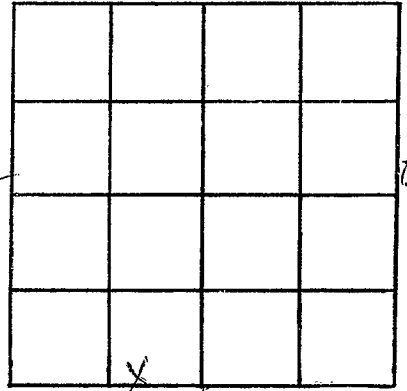

SECTION E

Please indicate well location X.

ADDITIONAL INFORMATION

If more than one screen,
show locations of each on sketch.