

Tate  
 H 2015  
 12-11-75

MISSISSIPPI  
 BOARD OF WATER COMMISSIONERS  
 416 North State Street  
 Jackson, Mississippi 39201

WATER WELL DRILLERS LOG

12-11-1975 <sup>15E</sup> ~~Hicks Well Co~~ TATE  
 date well completed firm name county well located

|                                  |                                       |           |            |
|----------------------------------|---------------------------------------|-----------|------------|
| LANDOWNER: <u>Odel Sharp</u>     | description of formations encountered | from      | to         |
| <u>Rt. 2 Coldwater</u>           |                                       |           |            |
| <u>MISS</u><br>(mailing address) | <u>Red sand</u>                       | <u>0</u>  | <u>10</u>  |
|                                  | <u>white sand</u>                     | <u>10</u> | <u>140</u> |

WELL LOCATION:  
 sec. 10 T. 5 N. R. 6 E.  
 (distance) miles (direction) of Senatobia  
 (nearest town)


WELL PURPOSE: Home  
 (home, irrigation, municipal, industrial)

- WELL COMPLETION DATA:
- (1) diameter (inches) 4"
  - (2) total depth (feet) 140
  - (3) static water level (feet) 50 below above top of ground.
  - (4) casing PVC, 140  
(material) (depth)  
(size) if telescope see back.
  - (5) screen 7", 7"  
(length) (depth to top)  
4", PVC INSIDE GRAVEL  
(size) (material)
  - (6) pump 1/2, 10  
(HP) (yield gpm)  
220 F  
(type power)
  - (7) electric log (yes or no)
  - (organization running log)
  - (8) how well bottom plugged CAP

DRILLERS REMARKS: DEC 22 1975  
 MISSISSIPPI BOARD OF WATER COMMISSIONERS

If well telescopes please sketch and show depths.

GROUND LEVEL

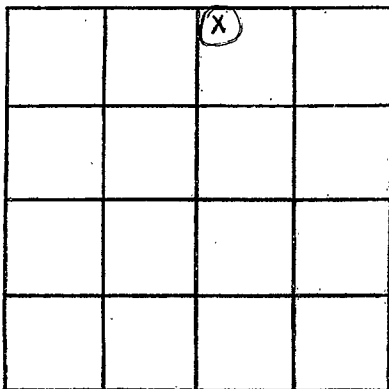

SECTION \_\_\_\_\_

Please indicate well location X.

ADDITIONAL INFORMATION

If more than one screen, show locations of each on sketch.