

Jata
H 2007
4-17-76

MISSISSIPPI
 BOARD OF WATER COMMISSIONERS
 416 North State Street
 Jackson, Mississippi 39201


WATER WELL DRILLERS LOG

4-17 1976 Harris Bros. Jata
 date well completed firm name county well located

LANDOWNER: <u>James Biggley</u> <u>Rt. 1</u>	description of formations encountered	from	to
<u>Sanatobia</u> (mailing address)	<u>top soil</u>	<u>0</u>	<u>20</u>
WELL LOCATION: sec <u>20</u> T <u>5</u> N R <u>6</u> E <u>2 1/2</u> miles <u>N</u> of <u>Longhorn</u> (distance) (direction) (nearest town)	<u>Clay + sand</u>	<u>20</u>	<u>85</u>
WELL PURPOSE: <u>home</u> (home, irrigation, municipal, industrial)	<u>Coarse sand</u>	<u>85</u>	<u>100</u>
WELL COMPLETION DATA: (1) diameter (inches) <u>4</u> (2) total depth (feet) <u>100</u> (3) static water level (feet) <u>60</u> <u>below</u> top of ground. (4) casing <u>Plaster 93'</u> (material) (depth) <u>4</u> (size) If telescope see back. (5) screen <u>7</u> <u>93</u> (length) (depth to top) <u>408</u> <u>Plaster</u> (size) (material) (6) pump <u>3/4</u> <u>10</u> (HP) (yield gpm) <u>slow</u> (type power) (7) electric log <u>no</u> (yes or no) (organization running log) (8) how well bottom plugged <u>solid</u>			
DRILLERS REMARKS:	<p style="text-align: center;">RECEIVED OCT 22 1976 MISS. BD. OF WATER COMMISSIONERS</p>		

If well telescopes please sketch and show depths.

GROUND LEVEL

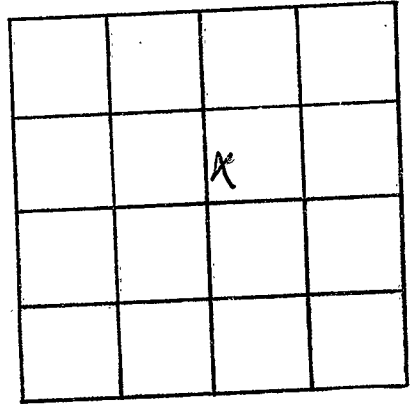

SECTION 20

Please indicate well location X.

ADDITIONAL INFORMATION

If more than one screen,
show locations of each on sketch.