

Date
 H 2018
 6-8-76

MISSISSIPPI
 BOARD OF WATER COMMISSIONERS
 416 North State Street
 Jackson, Mississippi 39201

WATER WELL DRILLERS LOG


6-8 1976 *Hicks Wellers* Date
 date well completed firm name county well located

LANDOWNER: <i>Melvin Boyd</i>	description of formations encountered	from	to
<i>Rt. 2</i>			
<i>Coldwater, Miss.</i> (mailing address)	<i>Red Clay</i>	<i>0</i>	<i>10</i>
	<i>Red Sand</i>	<i>10</i>	<i>60</i>
	<i>Red Sand & clay</i>	<i>60</i>	<i>100</i>
	<i>White Sand</i>	<i>100</i>	<i>145</i>
WELL LOCATION: sec. <i>11</i> T. <i>5</i> N R. <i>6</i> E <i>11</i> miles <i>E</i> of <i>Coldwater</i> (distance) (direction) (nearest town)			
WELL PURPOSE: <i>Home</i> (home, irrigation, municipal, industrial)			
WELL COMPLETION DATA:			
(1) diameter (inches) <i>4"</i>			
(2) total depth (feet) <i>145</i>			
(3) static water level (feet) <i>60</i> below top of ground.			
(4) casing <i>PVC</i> , <i>145</i> , (material) (depth) (size) if telescope see back.			
(5) screen <i>4'</i> , <i>141</i> (length) (depth to top) <i>4"</i> , <i>Gravel</i> (size) (material)			
(6) pump <i>4g</i> , <i>10</i> (HP) (yield gpm) <i>220</i> (type power)			
(7) electric log <i>NO</i> (yes or no)			
(organization running log)			
(8) how well bottom plugged <i>Cap</i>			
DRILLERS REMARKS:			

JUL - 1 1976
 MISS. ST. DE WATER

If well telescopes please sketch and show depths.

GROUND LEVEL

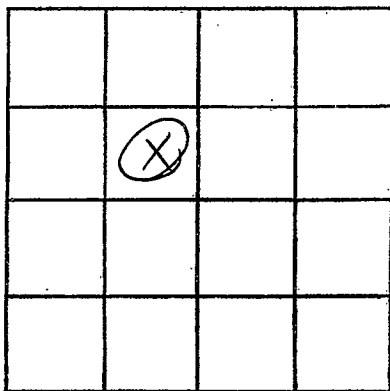

SECTION 11

Please indicate well location X.

ADDITIONAL INFORMATION

If more than one screen,
show locations of each on sketch.