

Tate
 H 2021
 7-6-76

MISSISSIPPI
 BOARD OF WATER COMMISSIONERS
 416 North State Street
 Jackson, Mississippi 39201

WATER WELL DRILLERS LOG

7-6-76 date well completed
 H. C. K. S. Well Co. firm name
 Tate county well located

LANDOWNER: Ernest Simpson
 5009 Milbranch Rd
 Memphis, Tenn.
 (mailing address)

Description of formations encountered	from	to
Red Sand & Clay	0	60
Red Sand	60	140
White Sand	140	200

WELL LOCATION:
 sec 25 T 5 N R 6 E
 1 miles S of Bam
 (distance) (direction) (nearest town)

WELL PURPOSE: Home
 (home, irrigation, municipal, industrial)

- WELL COMPLETION DATA:
- (1) diameter (inches) 4"
 - (2) total depth (feet) 220
 - (3) static water level (feet) 130 below top of ground.
 - (4) casing PVC 200 (material) (depth)
 - (size) If telescope see back.
 - (5) screen 4 1/2" 196 ft (length) (depth to top)
 - (size) gravel (material)
 - (6) pump 4 1/2 (HP) 10 (yield gpm)
 - 220 (type power)
 - (7) electric log NO (yes or no)
 - (organization running log)
 - (8) how well bottom plugged Cap


DRILLERS REMARKS:

RECEIVED
 JUL 28 1976

MISS. BD. OF WATER COMM

If well telescopes please sketch and show depths.

GROUND LEVEL

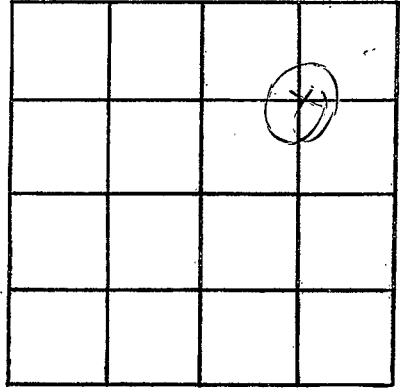

SECTION _____

Please indicate well location X.

ADDITIONAL INFORMATION

Lined area for additional information.

RECEIVED

If more than one screen, show locations of each on sketch.