

Tate  
 H 2024  
 12/15/76

MISSISSIPPI  
 BOARD OF WATER COMMISSIONERS  
 416 North State Street  
 15E Jackson, Mississippi 39201

WATER WELL DRILLERS LOG

12-15 1976 High Well Co. Tate  
 date well completed firm name county well located

LANDOWNER: J. W. Rushing  
 Rt. 2  
 Coldwater, Mo.  
 (mailing address)

description of formations encountered	from	to
Red Sand	0	60
White Sand	60	125
White Clay + Sand	125	145
White Sand	145	155

WELL LOCATION:  
 sec. 10 T. 5 N R. 6 E  
 3 miles S of Independence  
 (distance) (direction) (nearest town)

WELL PURPOSE: same  
 (home, irrigation, municipal, industrial)


- WELL COMPLETION DATA:
- (1) diameter (inches) 4
  - (2) total depth (feet) 155
  - (3) static water level (feet) 85 below above top of ground.
  - (4) casing PVC 155 (material) (depth)
  - (size) If telescope see back.
  - (5) screen 4" 151' (length) (depth to top)  
 4" Shovel type (size) (material)
  - (6) pump 1/2 10 (HP) (yield gpm)  
 220V (type power)
  - (7) electric log No (yes or no)
  - (organization running log)
  - (8) how well bottom plugged Cap

DRILLERS REMARKS:

RECEIVED  
 JAN 4 1977

If well telescopes please sketch and show depths.

GROUND LEVEL

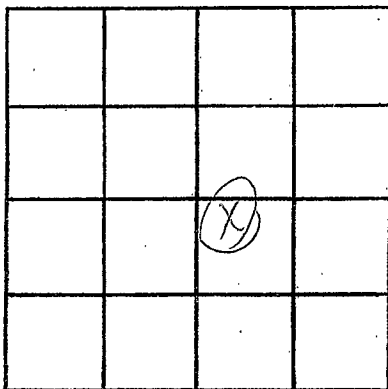

SECTION 10

Please indicate well location X.

ADDITIONAL INFORMATION

If more than one screen,  
show locations of each on sketch.