

Need better location on this
 this location about 6 mi E of Senatobia

TATE
 H 2027
 4-8-77

MISSISSIPPI
 BOARD OF WATER COMMISSIONERS
 416 North State Street
 Jackson, Mississippi 39201

File 6/2/9/77
 card book 7-5-77

WATER WELL DRILLERS LOG

4-8-1977 date well completed
 277 Dick Wall Co. firm name
 Tate county well located

LANDOWNER: Andy Dean
Rt. 1
Senatobia, Mo. 38668
 (mailing address)

description of formations encountered	from	to
Red Clay	0	15
White Sand	15	137

WELL LOCATION:
 sec 20 T S N R 6 E
~~2~~ miles ~~W~~ of ~~Senatobia~~ 2 1/2 miles North of Senatobia
 (distance) (direction) (nearest town)

Logahoma

WELL PURPOSE: Home
 (home, irrigation, municipal, industrial)

- WELL COMPLETION DATA:
- (1) diameter (inches) 4
 - (2) total depth (feet) 137
 - (3) static water level (feet) 60 below top of ground.
 - (4) casing PVC, 137
 (material) (depth)
 - (size) if telescope see back.
 - (5) screen 4", 133'
 (length) (depth to top)
 - 4" Gravel type
 (size) (material)
 - (6) pump 1/20 10
 (HP) (yield gpm)
 - 220V
 (type power)
 - (7) electric log No
 (yes or no)
 - (organization running log)
 - (8) how well bottom plugged Cap


DRILLERS REMARKS:

RECEIVED
 MAY 13 1977

MISS. Bd. of WATER COMMISSIONERS

If well telescopes please sketch and show depths.

GROUND LEVEL

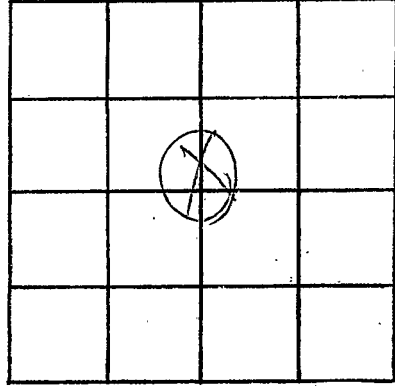

SECTION 20

Please indicate well location X:

ADDITIONAL INFORMATION

If more than one screen, show locations of each on sketch.