

Tate
 H 2028
 4-25-77

MISSISSIPPI
 BOARD OF WATER COMMISSIONERS
 416 North State Street
 Jackson, Mississippi 39201

WATER WELL DRILLERS LOG

4-25 1977 High Well Co. Tate
 date well completed firm name county well located

LANDOWNER: Jesse Davis
 Pt. 2
 Coldwater, Ms.
 (mailing address)

description of formations encountered	from	to
Red Clay	0	10
Red Clay & Gravel	10	15
White Sand	15	95

WELL LOCATION:
 sec. 1 T 5 N R 6 E
 2 1/2 miles SE of Independence
 (distance) (direction) (nearest town)

WELL PURPOSE: Home
 (home, irrigation, municipal, industrial)

WELL COMPLETION DATA:
 (1) diameter (inches) 4
 (2) total depth (feet) 95
 (3) static water level (feet) 60 below above top of ground.
 (4) casing PVC 95' (material) (depth)
 (size) if telescope see back.
 (5) screen 4' 91' (length) (depth to top)
 4" gravel type (size) (material)
 (6) pump 1/2 10 (HP) (yield gpm)
 220V (type power)
 (7) electric log No (yes or no)
 (organization running log)
 (8) how well bottom plugged Cap


DRILLERS REMARKS:

RECEIVED
 MAY 23 1977

MISS. BD. OF WATER COMM.

If well telescopes please sketch and show depths.

GROUND LEVEL

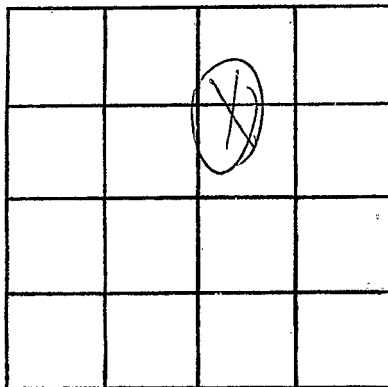

SECTION 1

Please indicate well location X.

ADDITIONAL INFORMATION

If more than one screen, show locations of each on sketch.