

Tate  
 H 2032  
 6-25-77

MISSISSIPPI  
 BOARD OF WATER COMMISSIONERS  
 416 North State Street  
 15E Jackson, Mississippi 39201

WATER WELL DRILLERS LOG


6-25-77 date well completed  
 W.A. Mason firm name  
 Tate county well located

LANDOWNER:	description of formations encountered	from	to
Major Tate	clay silt	70	12
R.F. Senatobia Miss. (mailing address)	Red Sand	12	32
<b>WELL LOCATION:</b> sec. 16 T. 5 N. R. 6 E. 3 1/2 miles S S of Rowman (distance) (direction) (nearest town)	White Sand	32	130
<b>WELL PURPOSE:</b> Home (home, irrigation, municipal, industrial)			
<b>WELL COMPLETION DATA:</b> (1) diameter (inches) 4 1/4 (2) total depth (feet) 130' (3) static water level (feet) 55' below top of ground (4) casing <u>Plaster 120'</u> (material) (depth) 4" if telescope see back. (size) (5) screen <u>10' 120'</u> (length) (depth to top) 4" Plaster (size) (material) (6) pump <u>3/4 10</u> (HP) (yield gpm) electric (type power) (7) electric log <u>NO</u> (yes or no) (organization running log) (8) how well bottom plugged <u>Coop</u>			
<b>DRILLERS REMARKS:</b>			

**RECEIVED**  
 JUL 7 - 1977  
 MISS. BD. OF WATER COMMISSIONERS

If well telescopes please sketch and show depths.

GROUND LEVEL

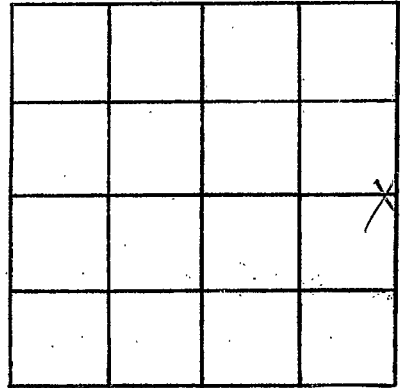

SECTION 1.6

Please indicate well location X.

ADDITIONAL INFORMATION

If more than one screen, show locations of each on sketch.