

Jate  
H 2033  
9-7-77

MISSISSIPPI  
 BOARD OF WATER COMMISSIONERS  
 416 North State Street  
 Jackson, Mississippi 39201

WATER WELL DRILLERS LOG

9-7 1977 Harris Bros. Jate  
 date well completed firm name county well located

LANDOWNER: Mike Strang

description of formations encountered

from to

pt. 4  
Coldwater  
 (mailing address)

top soil	0	20
fine sand	20	45
grey clay	45	130
fine sand	130	170
course sand	170	190

WELL LOCATION:

sec. S T. S N R. 6 E  
1 miles E of Pouville  
 (distance) (direction) (nearest town)

WELL PURPOSE: none  
 (home, irrigation, municipal, industrial)

WELL COMPLETION DATA:

- (1) diameter (inches) 4  
 (2) total depth (feet) 190  
 (3) static water level (feet) 100 below above top of ground.  
 (4) casing Plastic, 176  
 (material) (depth)  
4 if telescope see back.  
 (size)  
 (5) screen 14, 176  
 (length) (depth to top)  
008, Plastic  
 (size) (material)  
 (6) pump 3/4, 10  
 (HP) (yield gpm)  
elec.  
 (type power)  
 (7) electric log no  
 (yes or no)

(organization running log)

(8) how well bottom plugged solid

DRILLERS REMARKS:


**RECEIVED**

SEP 20 1977

MISS. BD. OF WATER COMM.

If well telescopes please sketch and show depths.

GROUND LEVEL

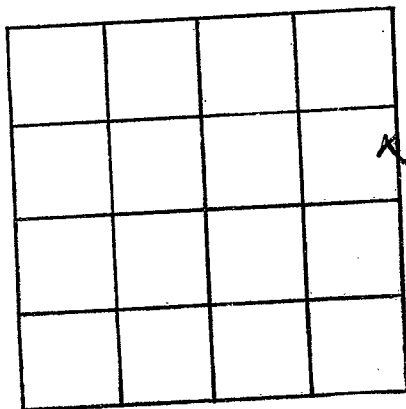

SECTION 5

Please indicate well location X.

ADDITIONAL INFORMATION

If more than one screen, show locations of each on sketch.