

TATE  
H 2034  
9-13-77

MISSISSIPPI  
BOARD OF WATER COMMISSIONERS  
416 North State Street  
15E Jackson, Mississippi 39201

WATER WELL DRILLERS LOG

9-13 1977 Hicks Well Co. Tate  
date well completed firm name county well located

LANDOWNER: Zion Hill Baptist Church - Rt. 1  
Senatobia, Ms.  
(mailing address)

description of formations encountered	from	to
Red Clay	0	40
Red Sand	40	90
White Sand & Clay	90	160
White Sand	160	230

WELL LOCATION:  
sec 25 T S N 6 E  
1/8 miles W of Bam  
(distance) (direction) (nearest town)

WELL PURPOSE: check  
(home, irrigation, municipal, industrial)

- WELL COMPLETION DATA:
- (1) diameter (inches) 4
  - (2) total depth (feet) 230
  - (3) static water level (feet) 60 below top of ground.
  - (4) casing PVC, 230,  
(material) (depth)  
(size) If telescope see back.
  - (5) screen 7', 223  
(length) (depth to top)  
4, gravel type  
(size) (material)
  - (6) pump 1/2 10  
(HP) (yield gpm)  
220V  
(type power)
  - (7) electric log No  
(yes or no)

(organization running log)  
(8) how well bottom plugged Cap


DRILLERS REMARKS:

**RECEIVED**

OCT 17 1977

If well telescopes please sketch and show depths.

GROUND LEVEL

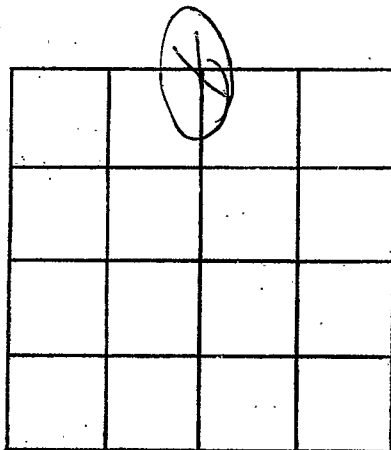

SECTION 25

Please indicate well location X.

ADDITIONAL INFORMATION

If more than one screen, show locations of each on sketch.