

Late
H 2036
10/30/77

MISSISSIPPI
 BOARD OF WATER COMMISSIONERS
 416 North State Street
 Jackson, Mississippi 39201

WATER WELL DRILLERS LOG

10-30 1977 W.A. Mason Late
 date well completed firm name county well located

LANDOWNER:
Jim Causey
Memphis Tenn.
 (mailing address)

description of formations encountered	from	to
<u>Clay</u>	<u>0</u>	<u>6</u>
<u>Red Sand</u>	<u>6</u>	<u>60</u>
<u>White clay</u>	<u>60</u>	<u>80</u>
<u>White Sand</u>	<u>80</u>	<u>135</u>

WELL LOCATION:
 sec. 5 T. 5 N. R. 6 E.
4 miles S of Independence
 (distance) (direction) (nearest town)

WELL PURPOSE: Home
 (home, irrigation, municipal, industrial)


- WELL COMPLETION DATA:
- (1) diameter (inches) 4"
 - (2) total depth (feet) 135'
 - (3) static water level (feet) 40' below top of ground
 - (4) casing Plasto 125'
 (material) (depth)
4" if telescope see back.
 (size)
 - (5) screen 10' 125'
 (length) (depth to top)
4" Plasto
 (size) (material)
 - (6) pump 3/4 10
 (HP) (yield gpm)
 (type power)
 - (7) electric log No
 (yes or no)
 (organization running log)
 - (8) how well bottom plugged cap

RECEIVED
 DEC 12 1977

DRILLERS REMARKS:

If well telescopes please sketch and show depths.

GROUND LEVEL

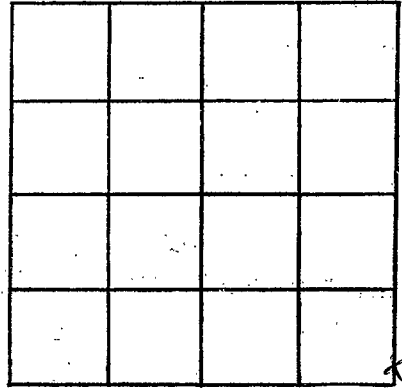

SECTION 10

Please indicate well location X.

ADDITIONAL INFORMATION

If more than one screen, show locations of each on sketch.