

TATE
H
2038

MISSISSIPPI
BOARD OF WATER COMMISSIONERS
416 North State Street
Jackson, Mississippi 39201

WATER WELL DRILLERS LOG

2-25-78 date well completed Bob Smith Wells firm name Jata county well located

LANDOWNER:
J. H. Anderson
(mailing address)

description of formations encountered	from	to
Top soil	0	5
Red Clay	5	15
Gravel	15	60
Sand	60	160

WELL LOCATION:
sec. 15 T. 5 N. R. 6 E. W. 10
6 miles (distance) of Dentaria (nearest town)

WELL PURPOSE:
(home, irrigation, municipal, industrial)

WELL COMPLETION DATA:

(1) diameter (inches) 4 1/2

(2) total depth (feet) 160

(3) static water level (feet) 100 below top of ground

(4) casing (material) plastic (depth) 160
(size) if telescope see back.


(5) screen (length) 10 (depth to top) 150
(size) 4 1/2 (material) plastic

(6) pump (HP) 1/2 (yield gpm) 5
(type power) Electric

(7) electric log (yes or no) (yes)

(organization running log)

(8) how well bottom plugged (plugged)

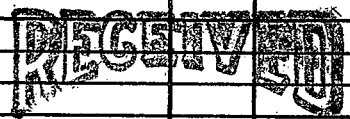

MAY 30 1978

DRILLERS REMARKS:

