

MISSISSIPPI
BOARD OF WATER COMMISSIONERS
 416 North State Street
 Jackson, Mississippi 39201
WATER WELL DRILLERS LOG


TATE
H 2041
9-5-78

9-5 1978 Hicks Well Co TATE
 date well completed firm name county well located

LANDOWNER: <u>Cathy Dandridge</u>	description of formations encountered	from	to
<u>RT-2</u>			
<u>Coldwater, MISS</u> (mailing address)	<u>Red clay</u>	<u>0</u>	<u>30</u>
	<u>Red clay & sand</u>	<u>30</u>	<u>60</u>
	<u>WC & sand</u>	<u>60</u>	<u>105</u>
	<u>W.S.</u>	<u>105</u>	<u>128</u>
WELL LOCATION:			
sec. <u>14</u> T. <u>5</u> N R. <u>6</u> E			
<div style="display: flex; justify-content: space-around;"> ③ ④ </div>			
<u>2</u> miles <u>N</u> of <u>WINN305</u>			
(distance) (direction) (nearest town)			
WELL PURPOSE: <u>Home</u> (home, irrigation, municipal, industrial)			
WELL COMPLETION DATA:			
(1) diameter (inches) <u>4"</u>			
(2) total depth (feet) <u>178</u>			
(3) static water level (feet) <u>80</u> below top of ground.			
(4) casing <u>PVC</u> , <u>178</u> , (material) (depth)			
<u> </u> (size) if telescope see back.			
(5) screen <u>7'</u> , <u>7'</u> (length) (depth to top)			
<u>4" O2</u> , <u>INSIDE ROCK</u> (size) (material)			
(6) pump <u>1/2</u> <u>10</u> (HP) (yield gpm)			
<u>2010 E101</u> (type power)			
(7) electric log _____ (yes or no)			
<u> </u> (organization running log)			
(8) how well bottom plugged <u>CAP</u>			
DRILLERS REMARKS:			

If well telescopes please sketch and show depths.

GROUND LEVEL

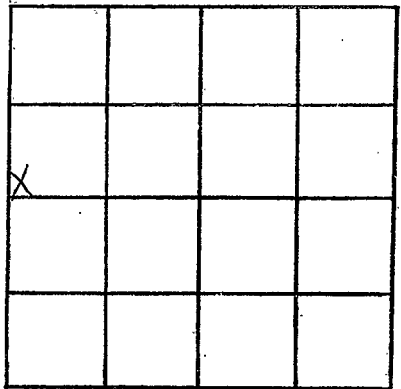

SECTION _____

Please indicate well location X.

ADDITIONAL INFORMATION

If more than one screen,
show locations of each on sketch.