

TATE
H 202
10-4-78

**MISSISSIPPI  
BOARD OF WATER COMMISSIONERS**  
416 North State Street  
Jackson, Mississippi 39201

**WATER WELL DRILLERS LOG**

10-4-78 date well completed      High Well Co firm name      Tate county well located

LANDOWNER: Bobby D. Bygler      description of formations encountered

Pat      from      to

Senatobia, MS      Red Clay      0      30

(mailing address)      Red Sand & Gravel      30      88

WELL LOCATION:

sec 20 T 5 N R 6 E

2 miles N of Senatobia

(distance) (direction) (nearest town)

WELL PURPOSE: Home

(home, irrigation; municipal, industrial)

WELL COMPLETION DATA:

(1) diameter (inches) 4

(2) total depth (feet) 105

(3) static water level (feet) 60 below above top of ground.

(4) casing PVC 105

(material) (depth)

(size) if telescope see back.

(5) screen 7' 98

(length) (depth to top)

4" gravel type

(size) (material)

(6) pump 1/2 10

(HP) (yield gpm)

220V

(type power)

(7) electric log No

(yes or no)

(organization running log)

(8) how well bottom plugged Cap


DRILLERS REMARKS:

**PROTECTIVE**

OCT 8 1978

If well telescopes please sketch and show depths.

GROUND LEVEL

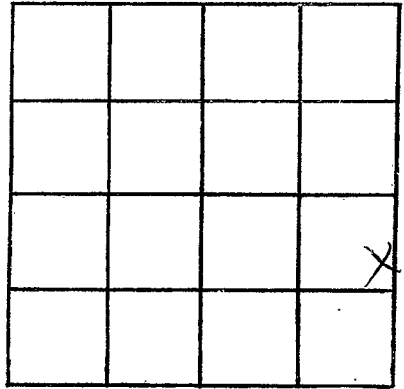

SECTION 20

Please indicate well location X.

ADDITIONAL INFORMATION

If more than one screen,  
show locations of each on sketch.