

TATE
H 2043
8-4-78

**MISSISSIPPI
BOARD OF WATER COMMISSIONERS**
416 North State Street
Jackson, Mississippi 39201

WATER WELL DRILLERS LOG

8-4 1978 HICKS Well 00 TATE
 date well completed firm name county well located


LANDOWNER: <u>Lee H Buford</u>	description of formations encountered	from	to
<u>PT-1 Senatobia</u>	<u>Red Clay</u>	<u>0</u>	<u>20</u>
<u>MISS</u>	<u>Red SAND 2072</u>	<u>20</u>	<u>90</u>
(mailing address)	<u>White SAND</u>	<u>90</u>	<u>147</u>
WELL LOCATION:			
sec <u>27</u> T <u>5</u> N R <u>6</u> E			
<u>2</u> Miles (distance) miles <u>E</u> (direction) of <u>Lookahome</u> (nearest town)			
WELL PURPOSE: <u>Home</u>			
(home, irrigation, municipal, industrial)			
WELL COMPLETION DATA:			
(1) diameter (inches) <u>4"</u>			
(2) total depth (feet) <u>147</u>			
(3) static water level (feet) <u>80</u> below above top of ground.			
(4) casing <u>PVC</u> <u>140</u> (material) (depth)			
_____ If telescope see back. (size)			
(5) screen <u>7"</u> <u>7'</u> (length) (depth to top)			
<u>4"</u> <u>Gravel INSIDE</u> (size) (material)			
(6) pump <u>1</u> <u>18</u> (HP) (yield gpm)			
<u>Elec</u> (type power)			
(7) electric log <u>NO</u> (yes or no)			
_____ (organization running log)			
(8) how well bottom plugged <u>CAP</u>			
DRILLERS REMARKS:			

RECEIVED
SEP 25 1978

MISS. BD. OF WATER COMMISSIONERS

If well telescopes please sketch and show depths.

GROUND LEVEL

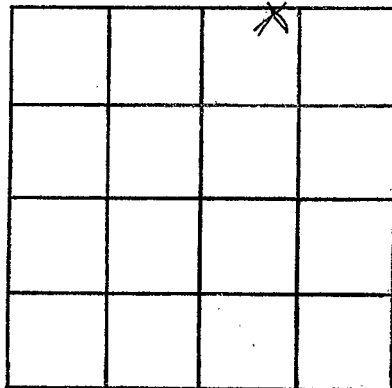

SECTION _____

Please indicate well location X.

ADDITIONAL INFORMATION

If more than one screen,
show locations of each on sketch.