

TATE
 H 2044
 9-25-78

MISSISSIPPI
 BOARD OF WATER COMMISSIONERS
 416 North State Street
 Jackson, Mississippi 39201

WATER WELL DRILLERS LOG

9-25-78 Hick Well Co Tate
 date well completed firm name county well located

LANDOWNER: Thomas Dyer
Ret.
Senatobia, Ms.
 (mailing address)

Description of formations encountered	from	to
Red Clay	0	15
Red Sand	15	90
White sand	90	125

WELL LOCATION:
 sec. 34 5 N R 6 E
2 miles E of New Town
 (distance) (direction) (nearest town)

WELL PURPOSE: Home
 (home, irrigation, municipal, industrial)

WELL COMPLETION DATA:
 (1) diameter (inches) 4"
 (2) total depth (feet) 125
 (3) static water level (feet) 60 below top of ground
 (4) casing PVC 125
 (material) (depth)
 (size) If telescope see back.
 (5) screen 7 118
 (length) (depth to top)
4 gravel type
 (size) (material)
 (6) pump 1/2 10
 (HP) (yield gpm)
220V
 (type power)
 (7) electric log No
 (yes or no)

(organization running log)
 (8) how well bottom plugged Cap


DRILLERS REMARKS:

RECEIVED
 OCT 30 1978

MISS. BD. OF WATER COMM

If well telescopes please sketch and show depths.

GROUND LEVEL

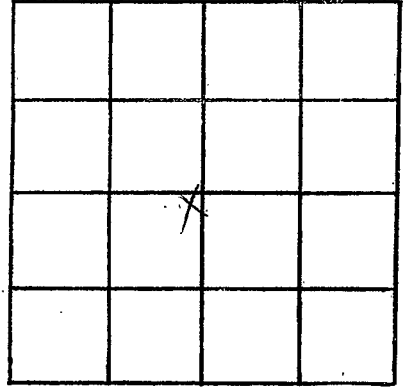

SECTION 30

Please indicate well location X.

ADDITIONAL INFORMATION

If more than one screen,
show locations of each on sketch.