

TATE
 H 2045
 10-31-78

MISSISSIPPI
 BOARD OF WATER COMMISSIONERS
 416 North State Street
 Jackson, Mississippi 39201

WATER WELL DRILLERS LOG


10-31-78 78 High Well Co Tate
 date well completed firm name county well located

LANDOWNER:	description of formations encountered	from	to
Albert Freeman (mailing address)	Red clay	0	10
Well location: sec. 16 T 5 N R 6 E W of Fradon (distance) miles (direction) of (nearest town)	Clay + Sand	18	35
Well purpose: Home (home, irrigation, municipal, industrial)	White Sand	35	85
Well completion data: (1) diameter (inches) 4 (2) total depth (feet) 85 (3) static water level (feet) 30 below top of ground. (4) casing PVC 85 (material) (depth) If telescope see back. (5) screen 7' 78 (length) (depth to top) 4' gravel top (size) (material) (6) pump 1/2 10 (HP) (yield gpm) 200V (type power) (7) electric log No (yes or no) (organization running log) (8) how well bottom plugged Cap			
DRILLERS REMARKS:			

RECEIVED
 NOV 13 1978
 MISS. BD. OF WATER COMMISSIONERS

If well telescopes please sketch and show depths.

GROUND LEVEL

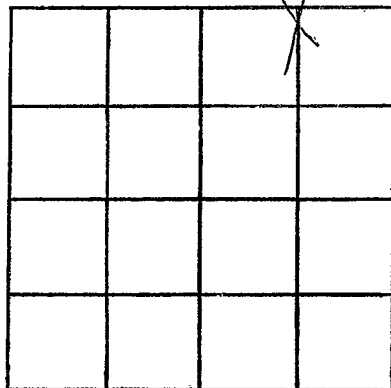

SECTION 16

Please indicate well location X.

ADDITIONAL INFORMATION

If more than one screen,
show locations of each on sketch.