

TATE
H 2046
3-28-79

MISSISSIPPI
BOARD OF WATER COMMISSIONERS
416 North State Street
Jackson, Mississippi 39201

WATER WELL DRILLERS LOG

3-12 19 79 Nick's Well Co. Tate
date well completed firm name county well located

LANDOWNER:
Phillip Meredith
Rt. 2 Coldwater Miss
(mailing address)

description of formations encountered	from	to
Red clay	0	30
Gravel & sand	30	90
Black Clay	90	125
White sand	125	150

WELL LOCATION:
sec. 5 T. 5 N. R. 6 E
2 miles Southeast of Plevin
(distance) (direction) (nearest town)

WELL PURPOSE: Home
(home, irrigation, municipal, industrial)

WELL COMPLETION DATA:
(1) diameter (inches) 4 in
(2) total depth (feet) 150
(3) static water level (feet) 80 below above top of ground.
(4) casing Plastic, 150 (material) (depth)
(size) if telescope see back.
(5) screen 7 ft. 143 (length) (depth to top)
4 in. Gravel (size) (material)
(6) pump 1/2 10 (HP) (yield gpm)
(type power)
(7) electric log NO (yes or no)
(organization running log)
(8) how well bottom plugged Cap.

DRILLERS REMARKS:


Miss. Board of Water Comm.

MAR 22 1979

RECEIVED

If well telescopes please sketch and show depths.

GROUND LEVEL

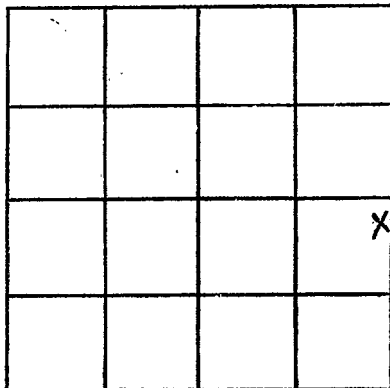

SECTION 5

Please indicate well location X.

ADDITIONAL INFORMATION

If more than one screen, show locations of each on sketch.