

Tate
 H 2052
 6-22-79

MISSISSIPPI
 BOARD OF WATER COMMISSIONERS
 416 North State Street
 Jackson, Mississippi 39201

WATER WELL DRILLERS LOG

6-22 19 79 Hecks Well Co. Tate
 date well completed firm name county well located

LANDOWNER:
W.N. Willhite
Rt. 4, Caldwellwater
 (mailing address)

description of formations encountered	depth	
	from	to
<u>Red Clay</u>	<u>0</u>	<u>20</u>
<u>Red Sand</u>	<u>20</u>	<u>80</u>
<u>White Sand</u>	<u>80</u>	<u>155</u>

WELL LOCATION:
 sec. 1 T. 5 N. R. 6 E.
Bell Community
 (distance) miles (direction) of (nearest town)

WELL PURPOSE: home
 (home, irrigation, municipal, industrial)


WELL COMPLETION DATA:
 (1) diameter (inches) 4 in
 (2) total depth (feet) 155
 (3) static water level (feet) _____ below above top of ground.
 (4) casing Plastic 155
 (material) (depth)
 (size) if telescope see back.
 (5) screen 7ft 148
 (length) (depth to top)
4 in gravel
 (size) (material)
 (6) pump 1/2 10
 (HP) (yield gpm)
220
 (type power)
 (7) electric log No
 (yes or no)
 (organization running log)
 (8) how well bottom plugged Cap

DRILLERS REMARKS:

Miss. Board of Water Comm.
 JUL 12 1979
 RECEIVED

If well telescopes please
sketch and show depths.

GROUND LEVEL

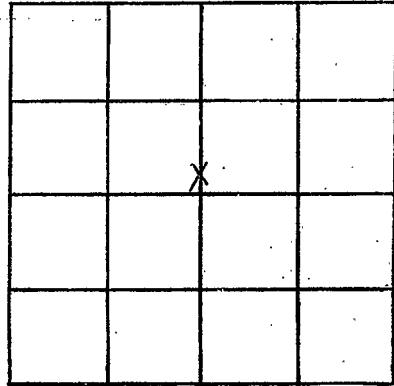

SECTION 1

Please indicate well location X.

ADDITIONAL INFORMATION

If more than one screen,
show locations of each on sketch.