

TATE
H 2053
8/12/79

**MISSISSIPPI
BOARD OF WATER COMMISSIONERS**
416 North State Street
Jackson, Mississippi 39201

WATER WELL DRILLERS LOG

8-12 1979 Nicks Wood Co. Jato
 date well completed firm name county well located

LANDOWNER:	description of formations encountered	from	to
<u>Thomas P. Leasday</u> <u>Bt. 2 Col. Watkins</u> (mailing address)			
WELL LOCATION: sec. <u>15</u> T <u>5</u> N R. <u>10</u> E <u>2</u> miles <u>NW</u> of <u>Loxahatchee</u> (distance) (direction) (nearest town)	<u>White clay</u>	<u>30</u>	<u>60</u>
WELL PURPOSE: <u>HOME</u> (home, irrigation, municipal, industrial)	<u>White sand</u>	<u>100</u>	<u>110</u>
WELL COMPLETION DATA:			
(1) diameter (inches) <u>4 in.</u>			
(2) total depth (feet) <u>110</u>			
(3) static water level (feet) _____ below/above top of ground.			
(4) casing <u>PLASTIC</u> , <u>110</u> , (material) (depth) _____ (size) If telescope see back.			
(5) screen <u>7 ft.</u> , <u>103 ft.</u> (length) (depth to top) <u>4 in.</u> , <u>ALUMINUM</u> (size) (material)			
(6) pump <u>1/2</u> <u>10</u> (HP) (yield gpm) <u>220</u> (type power)			
(7) electric log <u>NO</u> (yes or no) _____ (organization running log)			
(8) how well bottom plugged <u>CAP</u>			
DRILLERS REMARKS:			


Miss. Board of Water Comm.

AUG 27 1979

RECEIVED

If well telescopes please sketch and show depths.

GROUND LEVEL

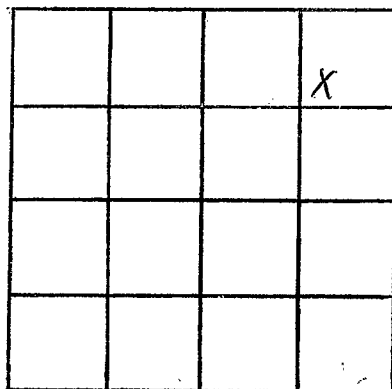

SECTION 15

Please indicate well location X.

ADDITIONAL INFORMATION

If more than one screen,
show locations of each on sketch.