

TATE
 # 2036
 4-3-80

MISSISSIPPI
 BOARD OF WATER COMMISSIONERS
 416 North State Street
 Jackson, Mississippi 39201

WATER WELL DRILLERS LOG

date well completed

firm name

county well located

19 80 Zeck's Well Co. Tate

LANDOWNER:
Jim Hendrich
Rt. 2, Coldwater
 (mailing address)

WELL LOCATION:
 sec. 5 T. 5 N. R. 6 E.
Pogerville Community
 (distance) miles (direction) of (nearest town)

WELL PURPOSE: Home
 (home, irrigation, municipal, industrial)

WELL COMPLETION DATA:

(1) diameter (inches) 4 in

(2) total depth (feet) 180

(3) static water level (feet) 100 below top of ground. 190 above

(4) casing Plastic 220 / 180
 (material) (depth)

(size) If telescope see back.

(5) screen 7 ft / 220 / 173
 (length) (depth to top)
4 in / Gravel
 (size) (material)

(6) pump 3/4 / 12
 (HP) (yield gpm)

220
 (type power)

(7) electric log NO
 (yes or no)

(organization running log)

(8) how well bottom plugged Cap


description of formations encountered	from	to
<u>Brown Clay</u>	0	50
<u>sand</u>	50	100
<u>Black Clay</u>	100	140
<u>white sand</u>	140	180

DRILLERS REMARKS:

DEPT. OF NATURAL RESOURCES
 BUREAU OF LAND & WATER RESOURCES
 APR 29 1980
 RECEIVED

If well telescopes please sketch and show depths.

GROUND LEVEL

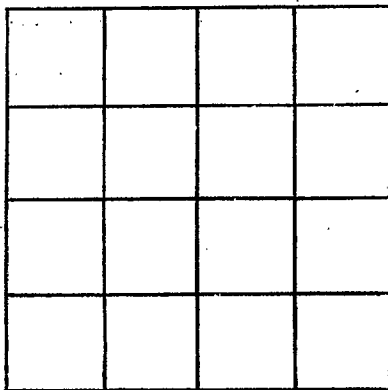

SECTION _____

Please indicate well location X.

ADDITIONAL INFORMATION

If more than one screen, show locations of each on sketch.