

Tate  
 H 2058  
 5-13-80

MISSISSIPPI  
 BOARD OF WATER COMMISSIONERS  
 416 North State Street  
 Jackson, Mississippi 39201

WATER WELL DRILLERS LOG

4-29 1980 Nicks Wellco Tate  
 date well completed firm name county well located

LANDOWNER:  
Morris Denton  
Pt. 2, Caldwellwater  
 (mailing address)

description of formations encountered	from	to
<u>clay</u>	<u>0</u>	<u>20</u>
<u>red sand</u>	<u>20</u>	<u>60</u>
<u>white sand</u>	<u>60</u>	<u>118</u>

WELL LOCATION:  
 sec. 15 T 5 N R 6 E  
1/2 miles E of Tate  
 (distance) (direction) (nearest town)

WELL PURPOSE: Home  
 (home, irrigation, municipal, industrial)

WELL COMPLETION DATA:  
 (1) diameter (inches) 4 in  
 (2) total depth (feet) 118  
 (3) static water level (feet) 70 below above top of ground.  
 (4) casing Plastic 118,  
 (material) (depth)  
 (size) If telescope see back.  
 (5) screen 7 ft, 111  
 (length) (depth to top)  
4 in, Gravel  
 (size) (material)  
 (6) pump 1/2 10  
 (HP) (yield gpm)  
200  
 (type power)  
 (7) electric log No  
 (yes or no)  
 (organization running log)  
 (8) how well bottom plugged Cap

DRILLERS REMARKS:


DEPT. OF NATURAL RESOURCES  
 BUREAU OF LAND & WATER RESOURCES

MAY 12 1980

RECEIVED

If well telescopes please  
sketch and show depths.

GROUND LEVEL

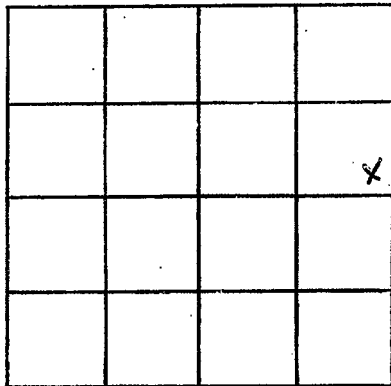

SECTION 15

Please indicate well location X.

ADDITIONAL INFORMATION

If more than one screen,  
show locations of each on sketch.