

TATE  
 H 2059  
 5-19-80

MISSISSIPPI  
 BOARD OF WATER COMMISSIONERS  
 416 North State Street  
 Jackson, Mississippi 39201

WATER WELL DRILLERS LOG

5-19 1980 Nicholas Co. Tate  
 date well completed firm name county well located

LANDOWNER:  
 B. J. EVANS  
 Rt. 1, Bonneton  
 (mailing address)

description of formations encountered	from	to
clay	0	30
red sand	30	80
white sand	80	110

WELL LOCATION:  
 sec. 4 T. 5 N R. 6 E  
 Independence  
 (distance) miles (direction) of (nearest town)

WELL PURPOSE: home  
 (home, irrigation, municipal, industrial)

- WELL COMPLETION DATA:
- (1) diameter (inches) 4
  - (2) total depth (feet) 110
  - (3) static water level (feet) 80 below above top of ground.
  - (4) casing pipe, 110 ft (material) (depth)
  - (size) if telescope see back.
  - (5) screen 2 ft, 103 ft (length) (depth to top)  
 4 in, galvanized (size) (material)
  - (6) pump 1/2 (HP) 10 (yield gpm)  
 220 (type power)
  - (7) electric log no (yes or no)  
 (organization running log)
  - (8) how well bottom plugged cap

DRILLERS REMARKS:


DEPT. OF NATURAL RESOURCES  
 BUREAU OF LAND & WATER RESOURCES

JUN 25 1980

RECEIVED

If well telescopes please sketch and show depths.

GROUND LEVEL

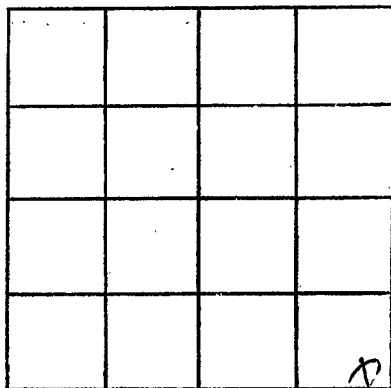

SECTION 14

Please indicate well location X.

ADDITIONAL INFORMATION

If more than one screen, show locations of each on sketch.