

TATE

H 2000
5-27-80

MISSISSIPPI  
BOARD OF WATER COMMISSIONERS  
416 North State Street  
Jackson, Mississippi 39201

WATER WELL DRILLERS LOG

5-27 1980 Nichols & Co. Jato  
date well completed firm name county well located

LANDOWNER:  
Badrk Dardridog  
Bt. 1, Sonatolia  
(mailing address)

description of formations encountered	from	to
<u>clay</u>	<u>0</u>	<u>30</u>
<u>red sand</u>	<u>30</u>	<u>70</u>
<u>white sand</u>	<u>70</u>	<u>110</u>

WELL LOCATION:  
sec 21 T 5 N R 10 E  
Jacouane  
miles of (nearest town)

WELL PURPOSE: home  
(home, irrigation, municipal, industrial)

WELL COMPLETION DATA:

(1) diameter (inches) 4

(2) total depth (feet) 110

(3) static water level (feet) 60 below top of ground.

(4) casing plastic 110,  
(material) (depth)  
(size) if telescope see back.

(5) screen 2ft 103  
(length) (depth to top)  
4in. galv  
(size) (material)

(6) pump 1/2 10  
(HP) (yield gpm)  
220  
(type power)

(7) electric log no  
(yes or no)  
(organization running log)

(8) how well bottom plugged cap

DEPT. OF NATURAL RESOURCES  
BUREAU OF LAND & WATER RESOURCES


JUN 25 1980

RECEIVED

DRILLERS REMARKS:

If well telescopes please sketch and show depths.

GROUND LEVEL

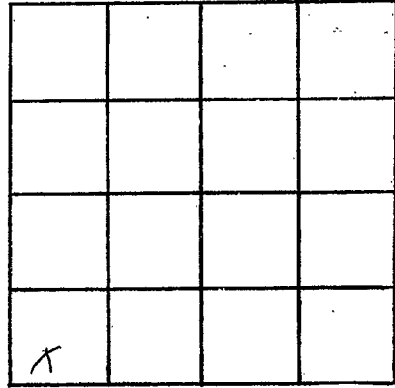

SECTION 21

Please indicate well location X.

ADDITIONAL INFORMATION

If more than one screen, show locations of each on sketch.