

TATE
H 2002
8-5-80

MISSISSIPPI
BOARD OF WATER COMMISSIONERS
416 North State Street
Jackson, Mississippi 39201

WATER WELL DRILLERS LOG

8-5 1980 Highs Well Co. Tate
date well completed firm name county well located

LANDOWNER: <u>Garry Treadwell</u>	description of formations encountered	from	to
<u>Rt. 2</u>			
<u>Caldwate, Ms.</u> (mailing address)	<u>clay</u>	<u>0</u>	<u>30</u>
WELL LOCATION:	<u>sand</u>	<u>30</u>	<u>90</u>
sec. <u>3</u> T <u>S</u> N <u>(S)</u> R <u>6</u> E <u>(W)</u>	<u>white sand</u>	<u>90</u>	<u>140</u>
<u>1 1/2</u> miles <u>S</u> of <u>Independence</u> (distance) (direction) (nearest town)			
WELL PURPOSE: <u>Home</u> (home, irrigation, municipal, industrial)			
WELL COMPLETION DATA:			
(1) diameter (inches) <u>4</u>			
(2) total depth (feet) <u>140</u>			
(3) static water level (feet) <u>100</u> below above top of ground.			
(4) casing <u>PVC</u> , <u>140</u> , (material) (depth)			
<u> </u> If telescope see back. (size)			
(5) screen <u>9"</u> , <u>133</u> (length) (depth to top)			
<u>4"</u> , <u>ground type</u> (size) (material)			
(6) pump <u>1/2</u> , <u>10</u> (HP) (yield gpm)			
<u>2200</u> (type power)			
(7) electric log <u>No</u> (yes or no)			
<u> </u> (organization running log)			
(8) how well bottom plugged <u>Cap</u>			

DRILLERS REMARKS:


DEPT. OF NATURAL RESOURCES
BUREAU OF LAND & WATER RESOURCES

SEP 26 1980

RECEIVED

If well telescopes please sketch and show depths.

GROUND LEVEL

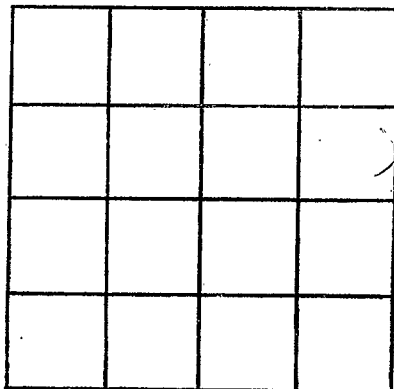

SECTION 3

Please indicate well location X.

ADDITIONAL INFORMATION

If more than one screen, show locations of each on sketch.