

MISSISSIPPI DEPARTMENT OF NATURAL RESOURCES

Bureau of Land and Water Resources

Southport Mall

P.O. Box 10631

Jackson, Mississippi 39209

WATER WELL DRILLERS LOG

TATE
H 2004
10-31-80

10-31-80 date well completed H.W. LIND CO. firm name Tate county well located


LANDOWNER: <u>Franis Jackson</u>	description of formations encountered	from	to
(R. 2)			
<u>Coldwater, Mo.</u> (mailing address)	<u>L.P. on sand</u>	10	125
WELL LOCATION:			
sec. <u>9</u> T. <u>5</u> N. R. <u>6</u> E.			
<u>1</u> miles (distance) of <u>7</u> (direction) of <u>7</u> (nearest town)			
WELL PURPOSE: (home, irrigation, municipal, industrial)			
WELL COMPLETION DATA:			
(1) diameter (inches) <u>4</u>			
(2) total depth (feet) <u>125</u>			
(3) static water level (feet) <u>60</u> below top of ground.			
(4) casing <u>PVC</u> (material), <u>125</u> (depth)			
<u> </u> (size) if telescope see back.			
(5) screen <u>7'</u> (length), <u>118</u> (depth to top)			
<u>2"</u> (size), <u>manuel type</u> (material)			
(6) pump <u>1/2</u> (HP), <u>10</u> (yield gpm)			
<u>220V</u> (type power)			
(7) electric log <u>No</u> (yes or no)			
<u> </u> (organization running log)			
(8) how well bottom plugged <u>Cap</u>			
DRILLERS REMARKS:			

DEPT. OF NATURAL RESOURCES
BUREAU OF LAND & WATER RESOURCES

DEC - 3 - 1980
RECEIVED

If well telescopes please sketch and show depths.

GROUND LEVEL

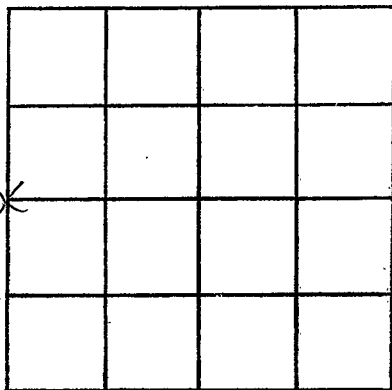

SECTION 9

Please indicate well location X.

ADDITIONAL INFORMATION

If more than one screen,
show locations of each on sketch.