

MISSISSIPPI DEPARTMENT OF NATURAL RESOURCES

Bureau of Land and Water Resources

Southport Mall

P.O. Box 10631

Jackson, Mississippi 39209

WATER WELL DRILLERS LOG

TATE
H 2005
11-26-80

1126 1980 date well completed Hicks Well Co. firm name Tate county well located

LANDOWNER: John Auer
Ref. 1
Senatobia, MS.
(mailing address)

description of formations encountered	from	to
Red clay	0	10
Red clay Red sand	10	30
white sand	30	145

WELL LOCATION:
sec. 29 T. 5 N. R. 6 E.
2 miles W of Senatobia
(distance) (direction) (nearest town)

WELL PURPOSE: Home
(home, irrigation, municipal, industrial)


- WELL COMPLETION DATA:
- (1) diameter (inches) 4
 - (2) total depth (feet) 145
 - (3) static water level (feet) 20 below top of ground.
 - (4) casing PVC, 145 (material), (depth)
 - (size) if telescope see back.
 - (5) screen 7, 138 (length), (depth to top)
 - 02 screen type (size) (material)
 - (6) pump 1/2, 10 (HP), (yield gpm)
 - 220V (type power)
 - (7) electric log No (yes or no)
 - (organization running log)
 - (8) how well bottom plugged Cap

DRILLERS REMARKS:

DEPT. OF NATURAL RESOURCES
BUREAU OF LAND & WATER RESOURCES
DEC 23 1980
RECEIVED

If well telescopes please sketch and show depths.

GROUND LEVEL

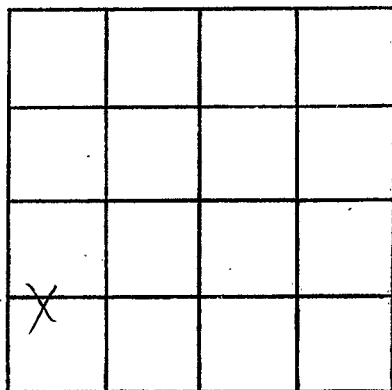

SECTION 29

Please indicate well location X.

ADDITIONAL INFORMATION

If more than one screen,
show locations of each on sketch.