

MISSISSIPPI DEPARTMENT OF NATURAL RESOURCES

Bureau of Land and Water Resources

Southport Mall

P.O. Box 10631

Jackson, Mississippi 39209

WATER WELL DRILLERS LOG

TATE
 #4 2000
 12-8-80

12/08/80 date well completed Hicks Well Co. firm name Tala county well located

LANDOWNER: W. T. Fisher
Rt. 1
Senatobia, Ms.
 (mailing address)

description of formations encountered	from	to
Red Clay	0	15
Red Sand	15	50

WELL LOCATION:
 sec. 26 T 5 N R 6 E
2 miles E of Josaphat
 (distance) (direction) (nearest town)

COm + Sand	50	95
White Sand	95	160

WELL PURPOSE: Home
 (home, irrigation, municipal, industrial)

WELL COMPLETION DATA:

(1) diameter (inches) 4

(2) total depth (feet) 160

(3) static water level (feet) 80 below above top of ground.

(4) casing RVC 160
 (material) (depth)

 If telescope see back.
 (size)

(5) screen 7 153
 (length) (depth to top)

12 metal case
 (size) (material)

(6) pump 1/2 10
 (HP) (yield gpm)

220V
 (type power)

(7) electric log No
 (yes or no)

(organization running log)

(8) how well bottom plugged Cap

DRILLERS REMARKS:


DEPT. OF NATURAL RESOURCES
 BUREAU OF LAND & WATER RESOURCES

DEC 23 1980

RECEIVED

If well telescopes please sketch and show depths.

GROUND LEVEL

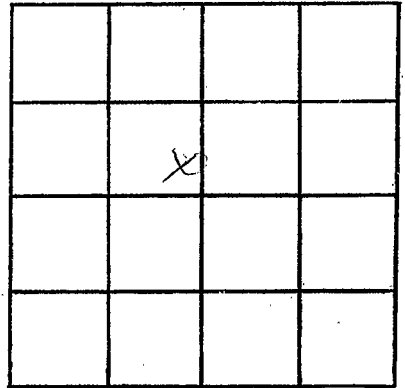

SECTION 26

Please indicate well location X.

ADDITIONAL INFORMATION

If more than one screen,
show locations of each on sketch.