

MISSISSIPPI DEPARTMENT OF NATURAL RESOURCES

Bureau of Land and Water Resources

Southport Mall

P.O. Box 10631

Jackson, Mississippi 39209

WATER WELL DRILLERS LOG

TATE  
H 2007  
3-2-81

3-2-1981 date well completed      Heisk Well Co. firm name      Tate county well located

LANDOWNER: John R. Price III  
Rt 1  
Senatobia, MS  
(mailing address)

description of formations encountered	from	to
Red Sand	0	10
Gravel	10	15
White Clay	15	95
White Clay + Sand	95	130
White Clay	130	145

WELL LOCATION:  
sec. 21 T 5 N R 6 E  
1 miles N of Brookhaven  
(distance) (direction) (nearest town)

WELL PURPOSE: Home  
(home, irrigation, municipal, industrial)

WELL COMPLETION DATA:


- (1) diameter (inches) 4
- (2) total depth (feet) 145
- (3) static water level (feet) 80 below top of ground.
- (4) casing PVC, 145 (material), (depth)
- (size) if telescope see back.
- (5) screen 10' 11.5' (length), (depth to top)  
2" Scotted PVC (size), (material)
- (6) pump 1/2 (HP), 10 (yield gpm)  
7.20V (type power)
- (7) electric log No (yes or no)
- (organization running log)
- (8) how well bottom plugged Cap

DRILLERS REMARKS:

DEPT. OF NATURAL RESOURCES  
BUREAU OF LAND & WATER RESOURCES  
MAR 18 1981  
**RECEIVED**

If well telescopes please sketch and show depths.

GROUND LEVEL

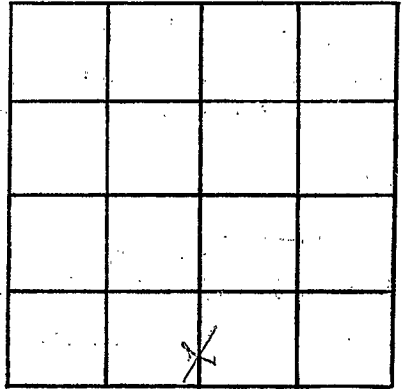

SECTION 21

Please indicate well location X.

ADDITIONAL INFORMATION

If more than one screen, show locations of each on sketch.