

MISSISSIPPI DEPARTMENT OF NATURAL RESOURCES

Bureau of Land and Water Resources

Southport Mall

P.O. Box 10631

Jackson, Mississippi 39209

WATER WELL DRILLERS LOG

TATE  
H 2068  
3-3-81

3-3 1981 date well completed      Hinds Well Co. firm name      Tate county well located

LANDOWNER: Claudio Will  
Rt. 1  
Senatobia, Ms.  
(mailing address)

description of formations encountered	from	to
Red Sand	0	45
White Clay	45	85
White Sand	85	115

WELL LOCATION:  
sec. 21 T. 5 N. R. 6 E  
3 miles NW of Senatobia  
(distance) (direction) (nearest town)

WELL PURPOSE: Home  
(home, irrigation, municipal, industrial)

WELL COMPLETION DATA:

(1) diameter (inches) 4

(2) total depth (feet) 115

(3) static water level (feet) 60 below above top of ground.

(4) casing PVC, 115  
(material) (depth)  
   if telescope see back.  
(size)

(5) screen 7, 108  
(length) (depth to top)  
4", gravel type  
(size) (material)

(6) pump 1/2, 1.0  
(HP) (yield gpm)  
220V  
(type power)

(7) electric log No  
(yes or no)  
   (organization running log)


(8) how well bottom plugged Cey

DRILLERS REMARKS:

DEPT. OF NATURAL RESOURCES  
BUREAU OF LAND & WATER RESOURCES  
MAR 18 1981  
RECEIVED

If well telescopes please sketch and show depths.

GROUND LEVEL

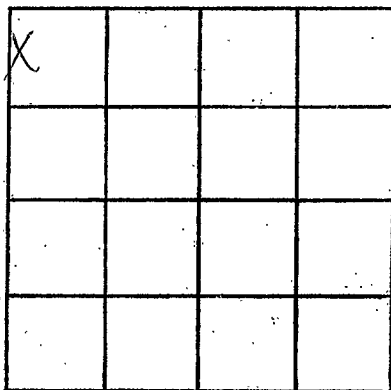

SECTION 21

Please indicate well location X.

ADDITIONAL INFORMATION

If more than one screen, show locations of each on sketch.