

MISSISSIPPI DEPARTMENT OF NATURAL RESOURCES

Bureau of Land and Water Resources

Southport Mall

P.O. Box 10631

Jackson, Mississippi 39209

WATER WELL DRILLERS LOG

TATE  
H 2009  
5/18/81


6-18 1981 date well completed  
Hicks Well Co. firm name  
Tate county well located

LANDOWNER: Jimmy Halder Rt. 1	description of formations encountered	from	to
Senstobles, Mo. (mailing address)			
	White Clay	50	80
	White Sand	80	140

WELL LOCATION:  
sec. 23 T 5 N R 6 E  
3 miles NE of Poplarhome  
(distance) (direction) (nearest town)

WELL PURPOSE: Home  
(home, irrigation, municipal, industrial)


- WELL COMPLETION DATA:
- (1) diameter (inches) 4"
  - (2) total depth (feet) 140
  - (3) static water level (feet) 60 below above top of ground.
  - (4) casing PVC 140 (material) (depth)  
(size) If telescope see back.
  - (5) screen 10 130 (length) (depth to top)  
4" PVC (size) (material)
  - (6) pump 1/2 10 (HP) (yield gpm)  
27.0V (type power)
  - (7) electric log No (yes or no)  
(organization running log)
  - (8) how well bottom plugged Cap

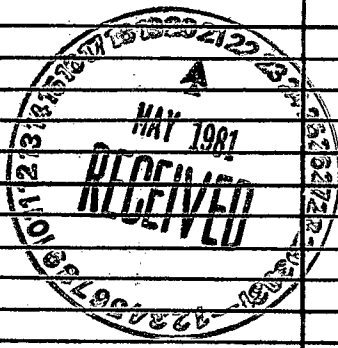

DRILLERS REMARKS:

If well telescopes please sketch and show depths.

GROUND LEVEL

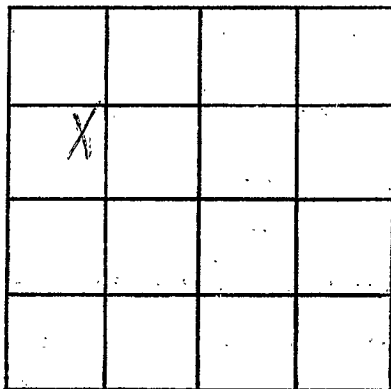

SECTION 23

Please indicate well location X.

ADDITIONAL INFORMATION

If more than one screen,  
show locations of each on sketch.