

MISSISSIPPI DEPARTMENT OF NATURAL RESOURCES

Bureau of Land and Water Resources

Southport Mall

P.O. Box 10631

Jackson, Mississippi 39209


WATER WELL DRILLERS LOG

6

TATE
H 2070
5-19-81


5-19 19 81 Hicks Well Co. Tate
 date well completed firm name county well located

LANDOWNER:	description of formations encountered	from	to
<u>Ned Morris</u> <u>Rt 1</u>			
<u>Senatobia, Mo.</u> (mailing address)	<u>white clay + sand</u>	<u>25</u>	<u>65</u>
WELL LOCATION: sec. <u>29</u> T <u>5</u> N R. <u>6</u> E <u>1</u> miles <u>NW</u> of <u>Senatobia</u> (distance) (direction) (nearest town)	<u>white sand</u>	<u>65</u>	<u>150</u>
WELL PURPOSE: <u>Home</u> (home, irrigation, municipal, industrial)			
WELL COMPLETION DATA: (1) diameter (inches) <u>4</u> (2) total depth (feet) <u>150</u> (3) static water level (feet) <u>80</u> below above top of ground. (4) casing <u>PVC</u> , <u>150</u> (material) (depth) <u>—</u> If telescope see back. (size) (5) screen <u>10</u> , <u>140</u> (length) (depth to top) <u>4"</u> , <u>PVC</u> (size) (material) (6) pump <u>1/2</u> , <u>10</u> (HP) (yield gpm) <u>220V</u> (type power) (7) electric log <u>No</u> (yes or no) (organization running log) (8) how well bottom plugged <u>Cap</u>			
DRILLERS REMARKS:			

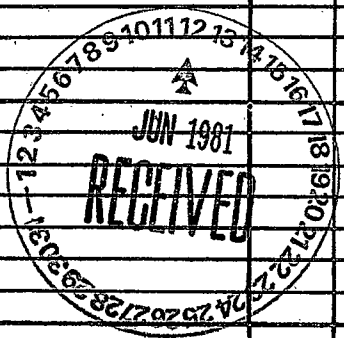

If well telescopes please sketch and show depths.

GROUND LEVEL

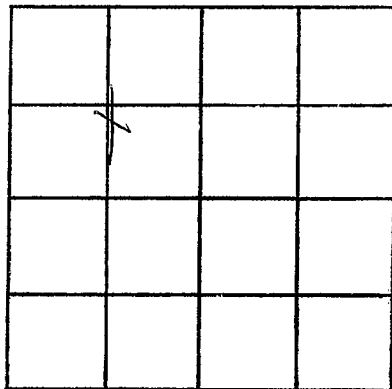

SECTION 29

Please indicate well location X.

ADDITIONAL INFORMATION

If more than one screen, show locations of each on sketch.