

MISSISSIPPI DEPARTMENT OF NATURAL RESOURCES

Bureau of Land and Water Resources

Southport Mall

P.O. Box 10631


Jackson, Mississippi 39209

WATER WELL DRILLERS LOG

| |
|--------|
| TATE |
| H 2021 |
| |
| 5-8-81 |


5-8-81 date well completed 1981 Hils Well Co. firm name Tate county well located

| LANDOWNER: <u>Danny Hickery</u> <u>Rt. 3</u> | description of formations encountered | from | to |
|---------------------------------------------------------------------------------------------------------------------------------------------------------------------------------------------------------------------------------------------------------------------------------------------------------------------------------------------------------------------------------------------------------------------------------------------------------------------------------------------------------------------------------------------------------------------------------------------|---------------------------------------|-----------|------------|
| <u>Senatobia, Ms.</u> (mailing address) | <u>Red Sand</u> | <u>0</u> | <u>50</u> |
| WELL LOCATION: sec. <u>29</u> T. <u>5</u> N. R. <u>6</u> E. <u>2</u> miles <u>W</u> of <u>Senatobia</u> (distance) (direction) (nearest town) | <u>White Sand</u> | <u>50</u> | <u>140</u> |
| WELL PURPOSE: <u>Home</u> (home, irrigation, municipal, industrial) | | | |
| WELL COMPLETION DATA: (1) diameter (inches) <u>4</u> (2) total depth (feet) <u>140</u> (3) static water level (feet) <u>80</u> below above top of ground. (4) casing <u>PVC</u> <u>140</u> (material) (depth) (size) if telescope see back. (5) screen <u>12</u> <u>128</u> (length) (depth to top) <u>4 1/2</u> <u>ground PVC</u> (size) (material) (6) pump <u>1/2</u> <u>10</u> (HP) (yield gpm) <u>2200</u> (type power) (7) electric log <u>NA</u> (yes or no) (organization running log) (8) how well bottom plugged <u>Cap</u> | | | |
| DRILLERS REMARKS: | | | |

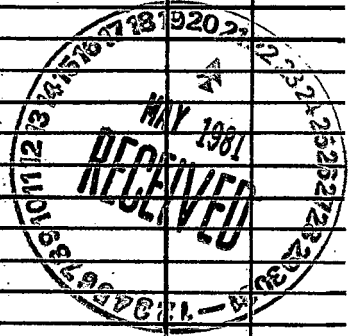

If well telescopes please sketch and show depths.

GROUND LEVEL

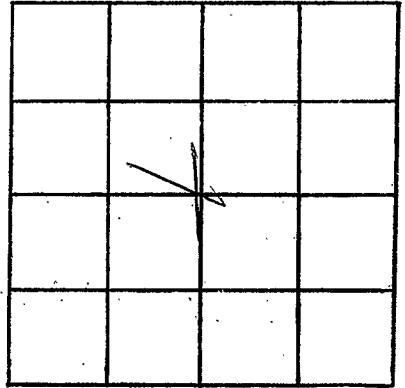

SECTION 29

Please indicate well location X.

ADDITIONAL INFORMATION

If more than one screen, show locations of each on sketch.