

MISSISSIPPI DEPARTMENT OF NATURAL RESOURCES

Bureau of Land and Water Resources

Southport Mall

P.O. Box 10631

Jackson, Mississippi 39209


WATER WELL DRILLERS LOG

13

Lot  
H 2073  
7-16-81


7-16 1981 Hicks Well Co. Tate  
 date well completed firm name county well located

LANDOWNER: <u>James Jordan</u> <u>Rt. 1</u>	description of formations encountered	from	to
<u>Senobia, Mo.</u> (mailing address)	<u>Red Clay</u>	<u>0</u>	<u>10</u>
WELL LOCATION: sec. <u>25</u> T <u>5</u> N R <u>6</u> E <u>1</u> miles <u>S</u> of <u>Ban</u> (distance) (direction) (nearest town)	<u>Red Sand</u>	<u>10</u>	<u>30</u>
WELL PURPOSE: <u>Home</u> (home, irrigation, municipal, industrial)	<u>White Sand</u>	<u>30</u>	<u>215</u>
WELL COMPLETION DATA: (1) diameter (inches) <u>4</u> (2) total depth (feet) <u>215</u> (3) static water level (feet) <u>160</u> below above top of ground. (4) casing <u>PVC</u> , <u>215</u> , (material) (depth) <u>—</u> If telescope see back. (size) (5) screen <u>12</u> , <u>203</u> (length) (depth to top) <u>4"</u> , <u>gravel + PVC</u> (size) (material) (6) pump <u>1/2</u> , <u>18</u> (HP) (yield gpm) <u>220V</u> (type power) (7) electric log <u>No</u> (yes or no)			
(organization running log) (8) how well bottom plugged <u>Cap</u>			
DRILLERS REMARKS:			

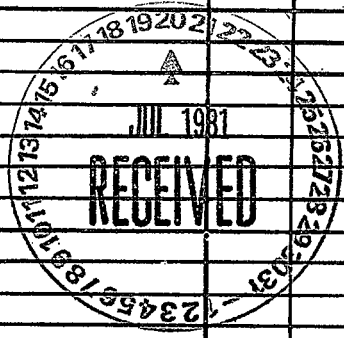

If well telescopes please sketch and show depths.

GROUND LEVEL

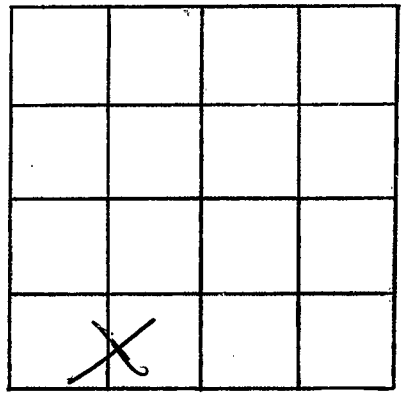

SECTION 25

Please indicate well location X.

ADDITIONAL INFORMATION

Lined area for additional information.

If more than one screen, show locations of each on sketch.