

MISSISSIPPI DEPARTMENT OF NATURAL RESOURCES
Bureau of Land and Water Resources
 Southport Mall
 P.O. Box 10631
 Jackson, Mississippi 39209
WATER WELL DRILLERS LOG

Date
H 2014

6-14-82 date well completed HICKS WELL COMPANY name Tate county well located

LANDOWNER: H.H. House
Rt. 1 Box 253
Senatobia, Miss. 38668
 (mailing address)

description of formations encountered	from	to
<u>Red Clay</u>	<u>0</u>	<u>20</u>
<u>Red Sand + Gravel</u>	<u>20</u>	<u>65</u>
<u>White Sand</u>	<u>65</u>	<u>130</u>

WELL LOCATION:
 sec. 27 T. 5 N. R. 6 E.
1 miles NE of Ladychana
 (distance) (direction) (nearest town)


WELL PURPOSE: Home
 (home, irrigation, municipal, industrial)

- WELL COMPLETION DATA:
- (1) diameter (inches) 4
 - (2) total depth (feet) 130
 - (3) static water level (feet) 80 below top of ground.
 - (4) casing PVC 130
 (material) (depth)
 - 4" if telescope see back.
 (size)
 - (5) screen 14 116
 (length) (depth to top)
 - 22 gravel + PK
 (size) (material)
 - (6) pump 1 18
 (HP) (yield gpm)
 - 220V
 (type power)
 - (7) electric log No
 (yes or no)
 - (organization running log)
 - (8) how well bottom plugged Cap

DRILLERS REMARKS:

If well telescopes please sketch and show depths.

GROUND LEVEL

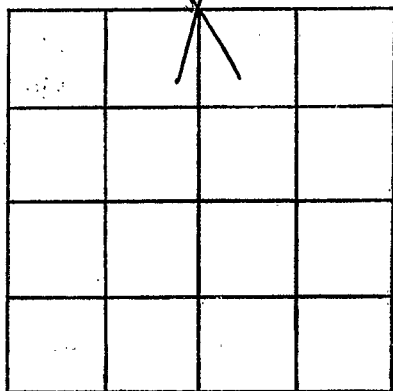

SECTION 27

Please indicate well location X.

ADDITIONAL INFORMATION

If more than one screen,
show locations of each on sketch.